

WATER SERVICE RECORD

Name *Leslie H. York*
Moore Homes Inc.

Service No. 61

Address 6 Franklin Road

Location

Repair—Renewal—New Service W.O.#7151 DeFlice #1511

DEC 28 1969


Date	Material	Amount	Total	Date	Amount
12/5/69	Labor	12.00		11-25-69	100 00
	10% O.H.	1.20	13.20	12-22-69	47 96
20'	3/4" Copper tubing @ .79		15.80		52 04
1	3/4" Corporation		9.57		
1	3/4" Curve Stop		8.37		
1	Box & Rod		5.10		
			52.04		
12-5-69	44' 3/4" Copper tubing				

DATE _____

TOWN OF LEXINGTON -- BOARD OF PUBLIC WORKS

WATER DIVISION

Sketch of Service Here

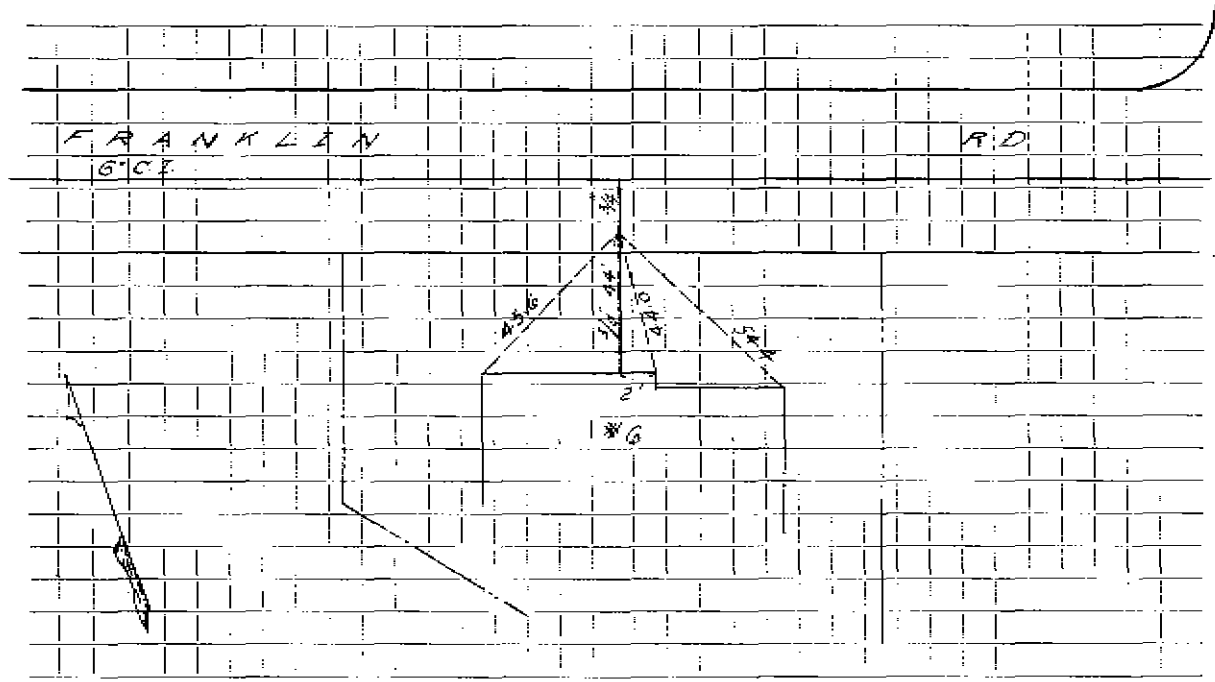


Connection made in Street. Work completed

Remarks:
.....
.....

DATE 7-7-1999

TOWN OF LEXINGTON — BOARD OF PUBLIC WORKS
WATER DIVISION

Sketch of Service Here

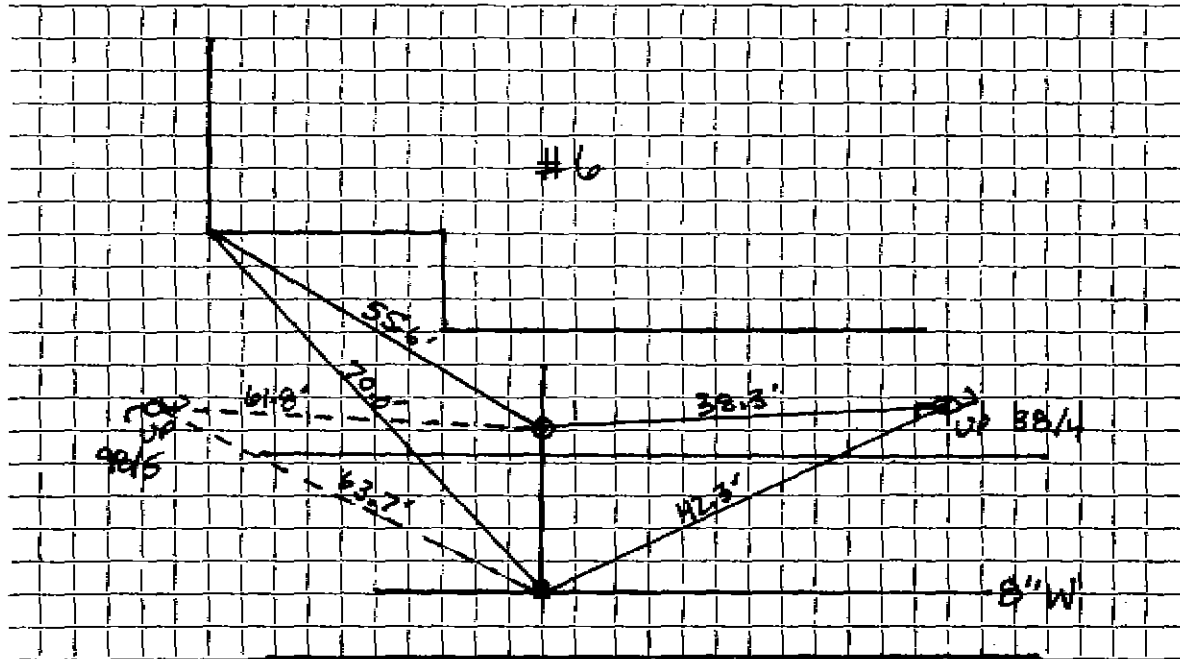

Connection made in 8" MAIN ON FRANKLIN RD Street.

Work completed NEW CORPORATION, CURBSIDE/BOX ...

Remarks:

.....

.....