


TOWN OF LEXINGTON - BOARD OF PUBLIC WORKS
WATER DIVISION

Date: 7/22/21

SKETCH OF SERVICE HERE

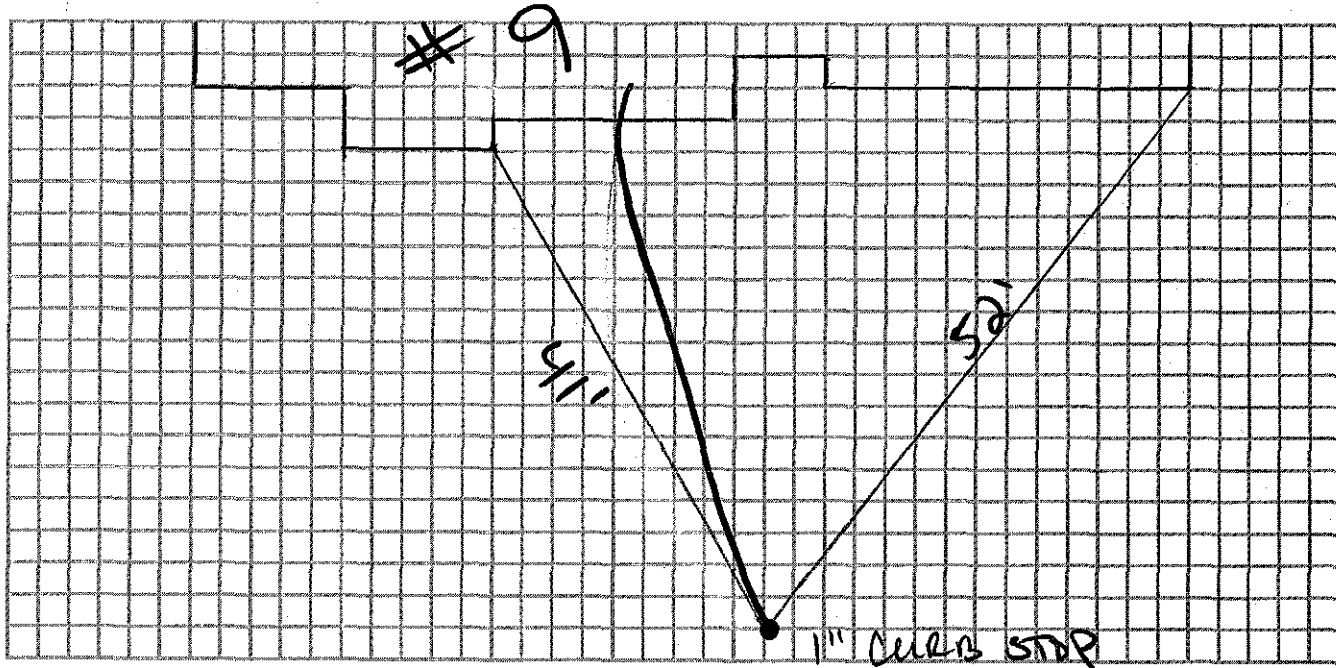

Connection made in: Franklin St Street.

Work completed:

Remarks:
.....
.....
.....
.....