


DATE 7-7-1999

TOWN OF LEXINGTON — BOARD OF PUBLIC WORKS
WATER DIVISION

Sketch of Service Here

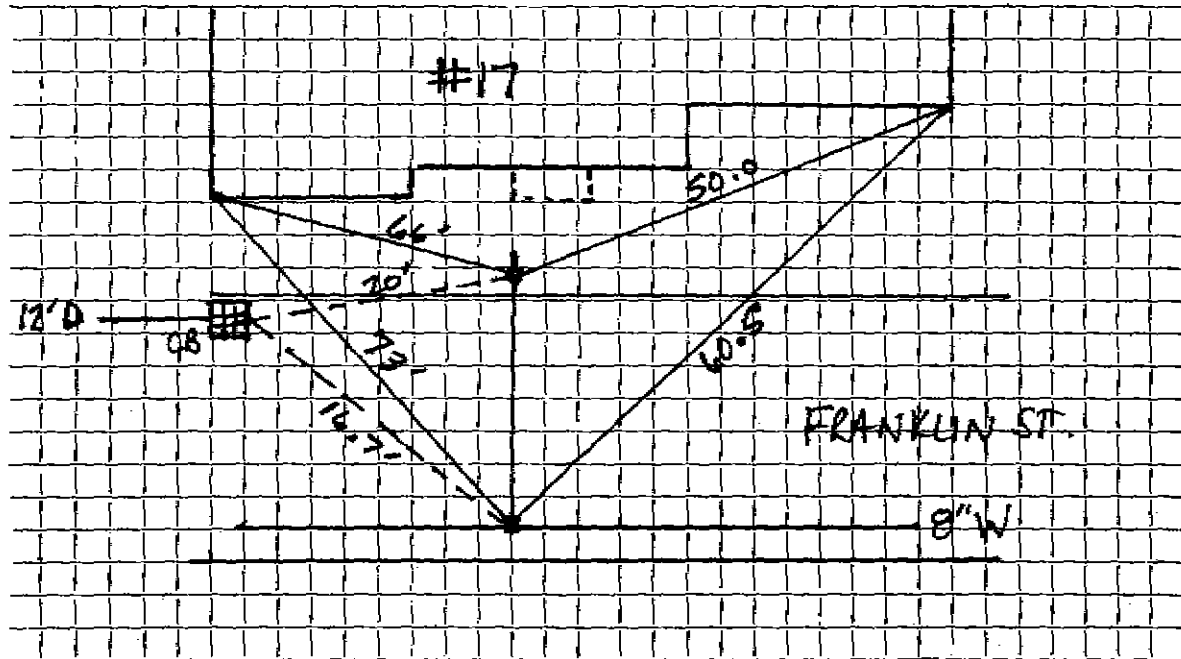

Connection made in 8" ~~W~~ MAIN ON FRANKLIN ROAD
Street.

Work completed NEW CONNECTION, CURBSTOP/BOX

Remarks:

.....

.....