


DATE _____

TOWN OF LEXINGTON — BOARD OF PUBLIC WORKS
WATER DIVISION

Sketch of Service Here

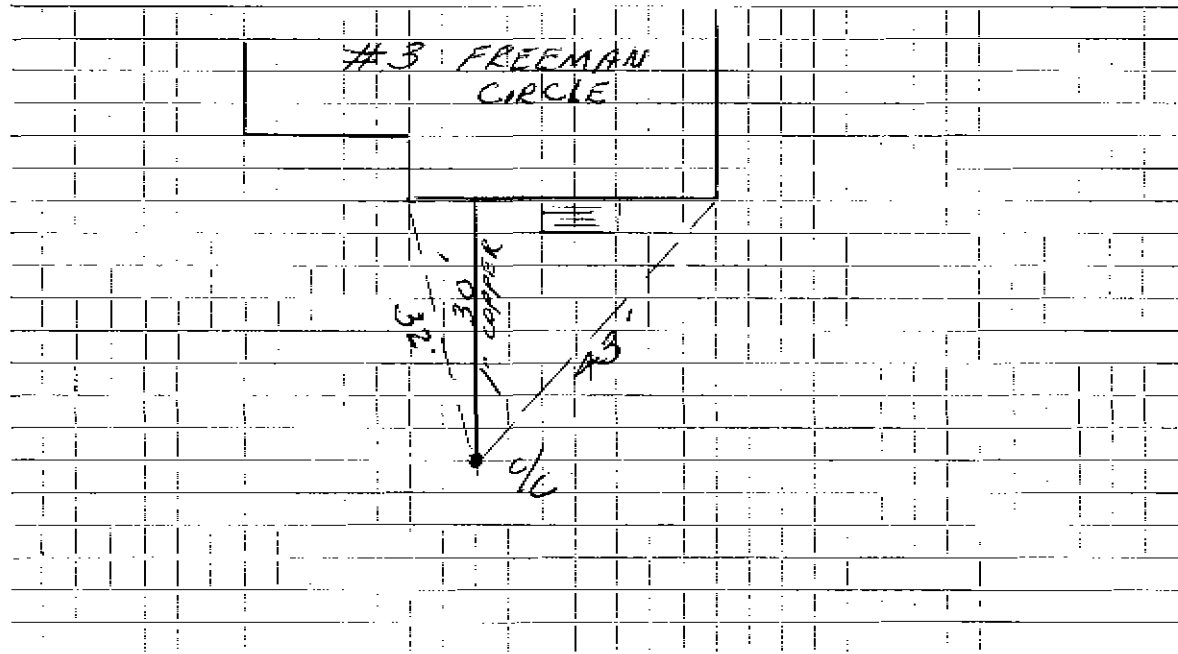

Connection made in FREEMAN CIRCLE Street.

Work completed

Remarks:
.....
.....