Name

Service No.

Address #4 FREEMAN CIRCLE

Location

Repair—Renewal—New Service

3/88


Date	Material	Amount	Total	Date		Amount
						! :
10/14/27	40 - / Coppek	2				:
7111					:	
:						
		:		::		
					•	
			1			
			: :			
				_		
			-	:		·
			:			
						:
	i					

DATE	<u>-</u>	<u> </u>

TOWN OF LEXINGTON - BOARD OF PUBLIC WORKS

WATER DIVISION

Sketch of Service Here

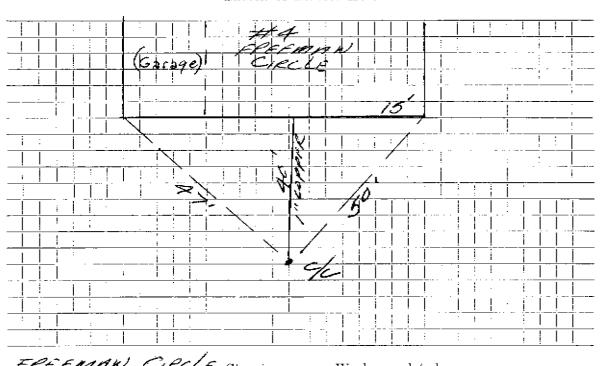

Connection made in TEELMING WELL Street.	Work completed
Remarks:	