
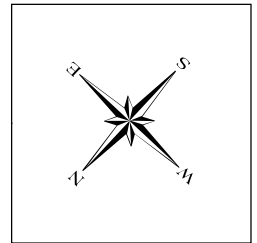


Water Service Tie Card
TOWN OF LEXINGTON
 MASSACHUSETTS

10 Freemont St

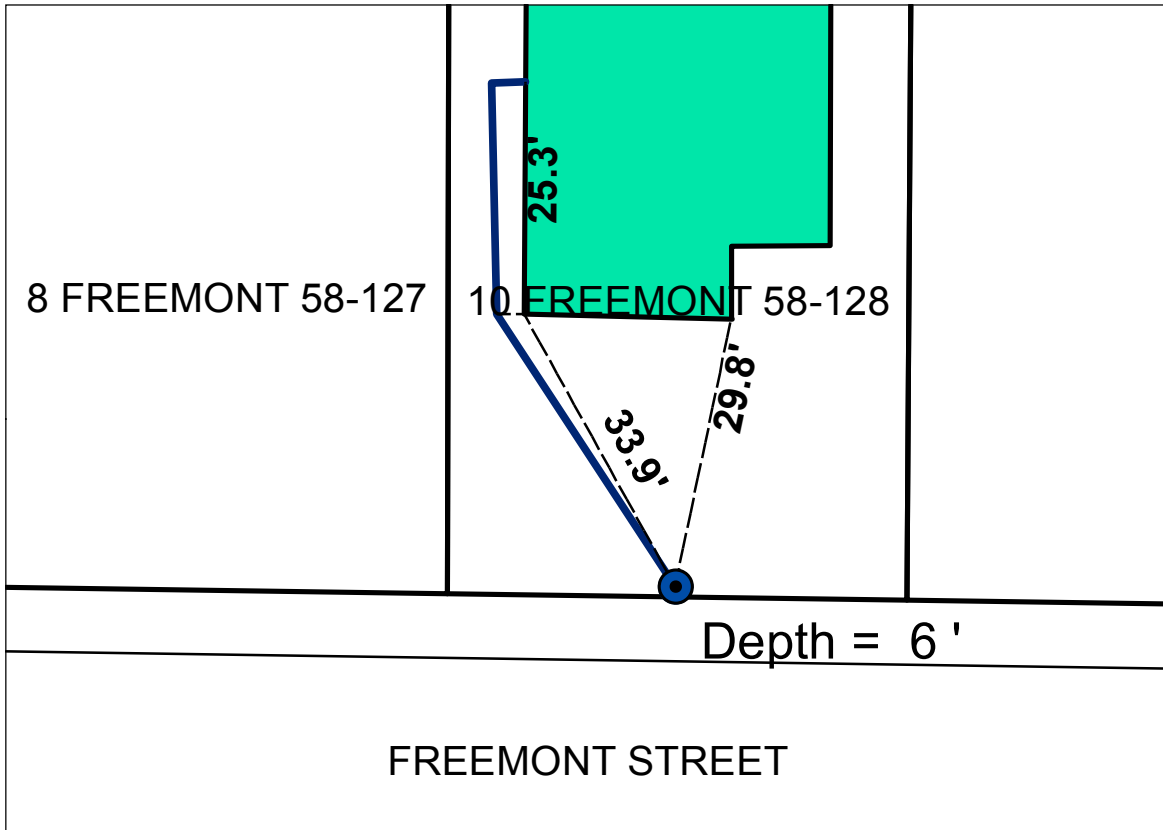

Legend	
	Curb Stop
	Ties_Dimensions
	Water Service Line
	Parcel_Polys_New
	Edge of Pavement
	CATCH BASIN

Address	Map and Lot	Permit Number	Contractor Name	Inspector
10 Freemont St	58-128	5767	McLaughlin, James M. Inc.	dpavlik msprague
Date	Material	Depth of Cover	Amount	
9/15/2014	3/4" Copper type "k"	6 ft	6"	
	3/4" to 1" fitting	6 ft	1	
	1" Copper type "k"	6 ft	1	
	1" Curb Valve and Buffalo Box	6 ft	66 ft to HSE	
Type of work completed				
New 1" water service to house from curb stop. New house on lot old house removed.				