

WATER SERVICE RECORD

1187

Name Custom Colonial Inc.

Service No. 313

Address 11 Fremont Street

Location

~~REPAIRS~~ ~~REPAIRS~~ New Service

Comm 2-8-60


Date	Material	Amount	Total	Date	Material	Amount
12-7-59	Labor	1.95		11-21-59	Deposit	25.00
	10% O.H.	.20	2.15	2-18-60	Paid	3.94
48'	3/4" Copper tubing @.42		20.16			28.94
1	3/4" C x 1/2 I.W.H. Stop & Waste		5.88		NON CHARGE	
1	hr. Trucking @.75		.75		Labor	1.61
			28.94	10'	3/4" Copper tubing @.42	4.20
				1	3/4" C Corp Cock	4.67
				1	3/4" C Curb Cock	5.98
				1	Box & Rod	5.00
				1	1/2 Straight tailpiece	.50
				1	1/2 Offset tailpiece	.50
						22.46

DATE \_\_\_\_\_

TOWN OF LEXINGTON — BOARD OF PUBLIC WORKS

**WATER DIVISION**

Sketch of Service Here

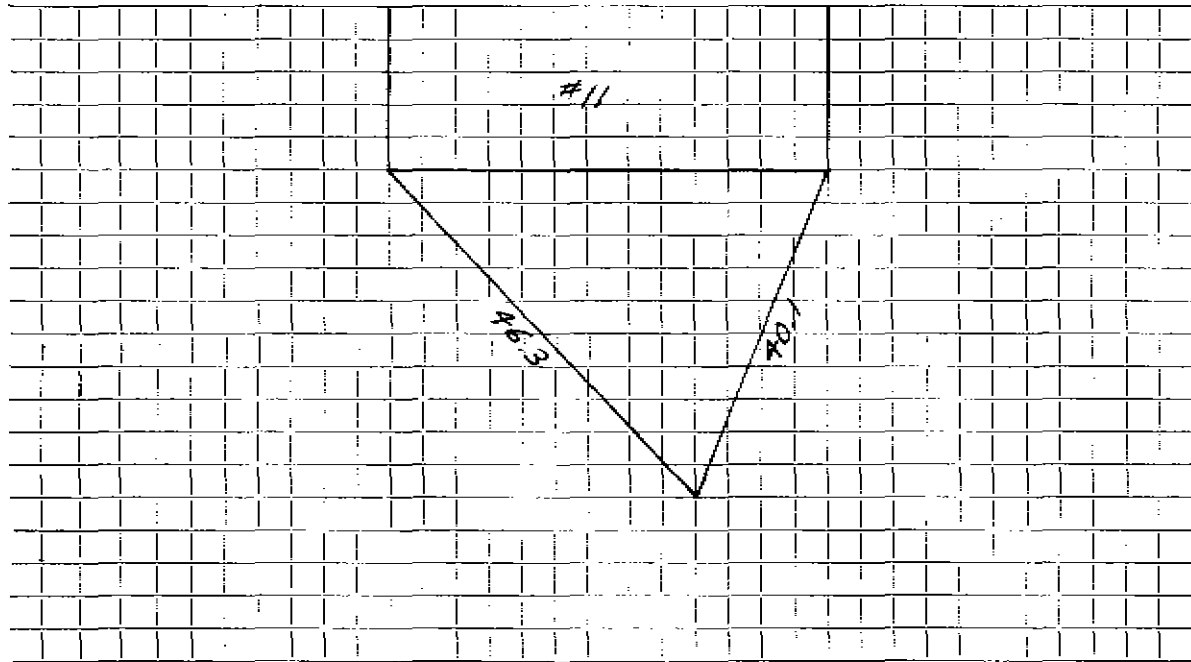

Connection made in ..... Street. Work completed .....

Remarks: .....

.....

.....