
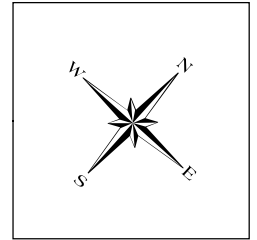


Water Service Tie Card
TOWN OF LEXINGTON
 MASSACHUSETTS

15 Freemont Street

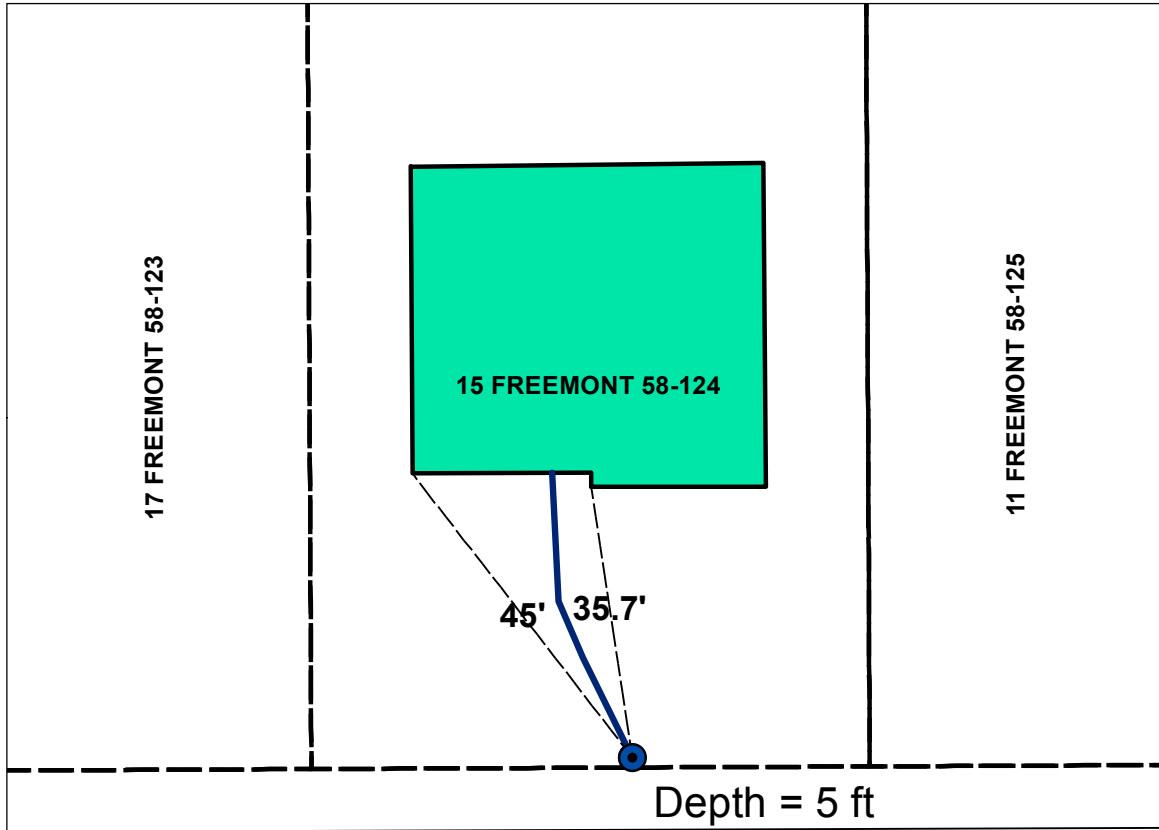

Legend	
	Curb Stop
	Ties_Dimensions
	Water Service Line
	Property Line
	Edge of Pavement

Address	Map and Lot	Permit Number	Contractor Name	Inspector
15 Freemont Street	58-124	5267	lovino	D. Pavlik

Date: 9/4/13	Material	Amount
	1" Curb Stop	
	1" Copper type "k"	42 Feet

Type of work completed
 New 1" water service to house from curb stop. New house on lot old house removed.