

WATER SERVICE RECORD

Name William H. Hamilton

Service No. 318

Address 22 Freemont Street

2814

Location

~~Repair~~ ~~Renewal~~ New Service


Comm 2-29-60

Date	Material	Amount	Total	Date	Amount	
12-16-59	Labor	1.85		12-2-59	Deposit	25 00
	10% O.H.	.19	2.04	2-29-60	Paid by SMC #249	7 19
56'	3/4" Copper tubing @ .42		23.52			32 19
1	3/4" Cx 1/2 I.W.E. Stop & Waste		5.88			
1	Hr. Trucking @ .75		.75		NON CHARGE	
			32.19		Labor	1.85
				24'	3/4" Copper tubing @ .42	10.08
				1	3/4" C Corp Cock	1.67
				1	3/4" C Curb Cock	5.98
				1	Box & Rod	5.00
				1	1/2" Offset Tailpiece	.50
				1	1/2" Straight tailpiece	.50
						28.58

TOWN OF LEXINGTON — BOARD OF PUBLIC WORKS

WATER DIVISION

Sketch of Service Here

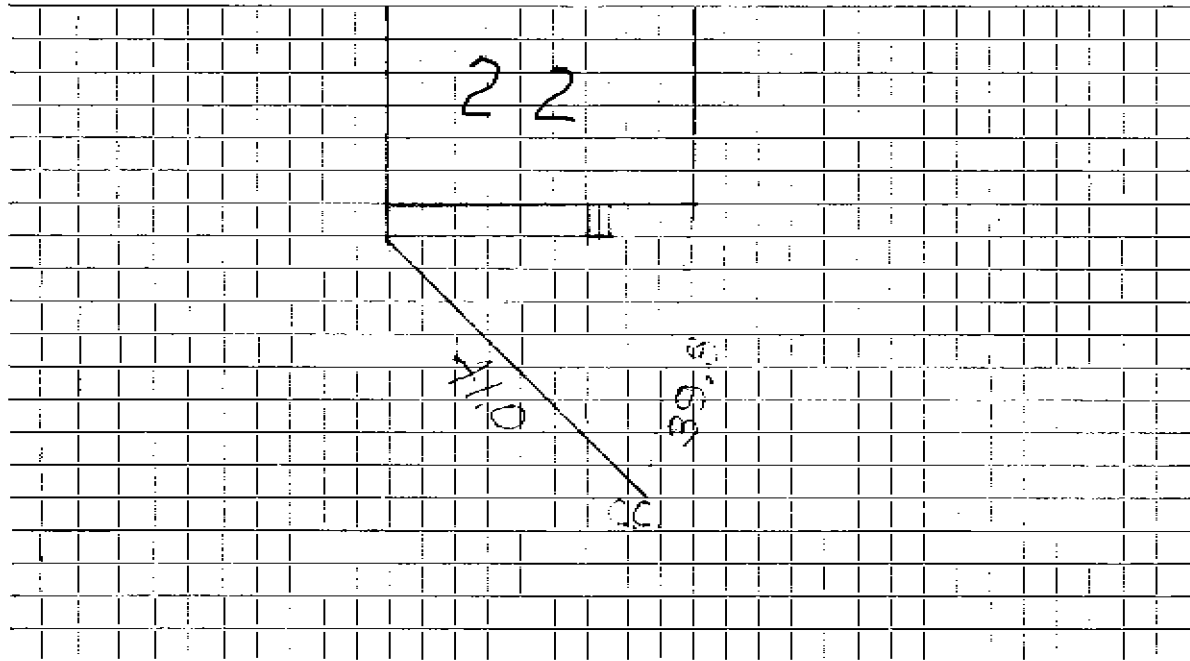

Connection made in Street. Work completed

Remarks:

.....

.....