

WATER SERVICE RECORD

#5081

Name John Bullock

Service No. 271

Address 33 Fremont Street

Location

~~Repair or Renewal~~ New Service

Comm 12-31-59


Date	Material	Amount	Total	Date	Amount	
10-27-59	Labor	2.01		10-27-59	Deposit	50.00
	10% O.H.	.20	2.21	11-31-59	Retund	15.96
	60' 3/4" Copper tubing @.42		25.20			34.04
	1 3/4" C x 1/2 I.W.E. Stop & Waste		5.88		NON CHARGE	
	1 hr. Trucking @.75		.75		Labor	1.61
			34.04		15' 3/4" Cooper tubing@.42	6.30
					1 3/4" C Corp Cock	4.67
					1 3/4" C Curb Cock	5.98
					1 Box & Rod	5.99
					1 1/2 Straight tailpiece	.50
					1 1/2 Offset tailpiece	.50
						24.56

DATE _____

TOWN OF LEXINGTON — BOARD OF PUBLIC WORKS

WATER DIVISION

Sketch of Service Here

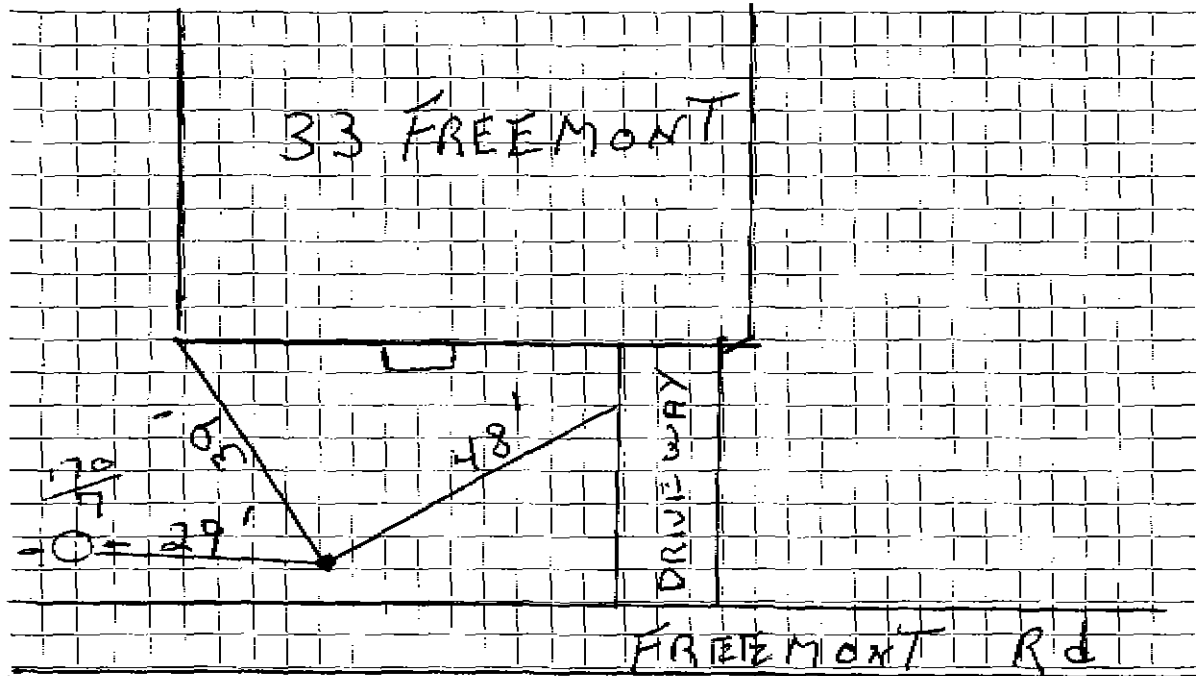

Connection made in Street. Work completed

Remarks:

.....
.....