


TOWN OF LEXINGTON - BOARD OF PUBLIC WORKS
WATER DIVISION

Date: 5/14/21

SKETCH OF SERVICE HERE

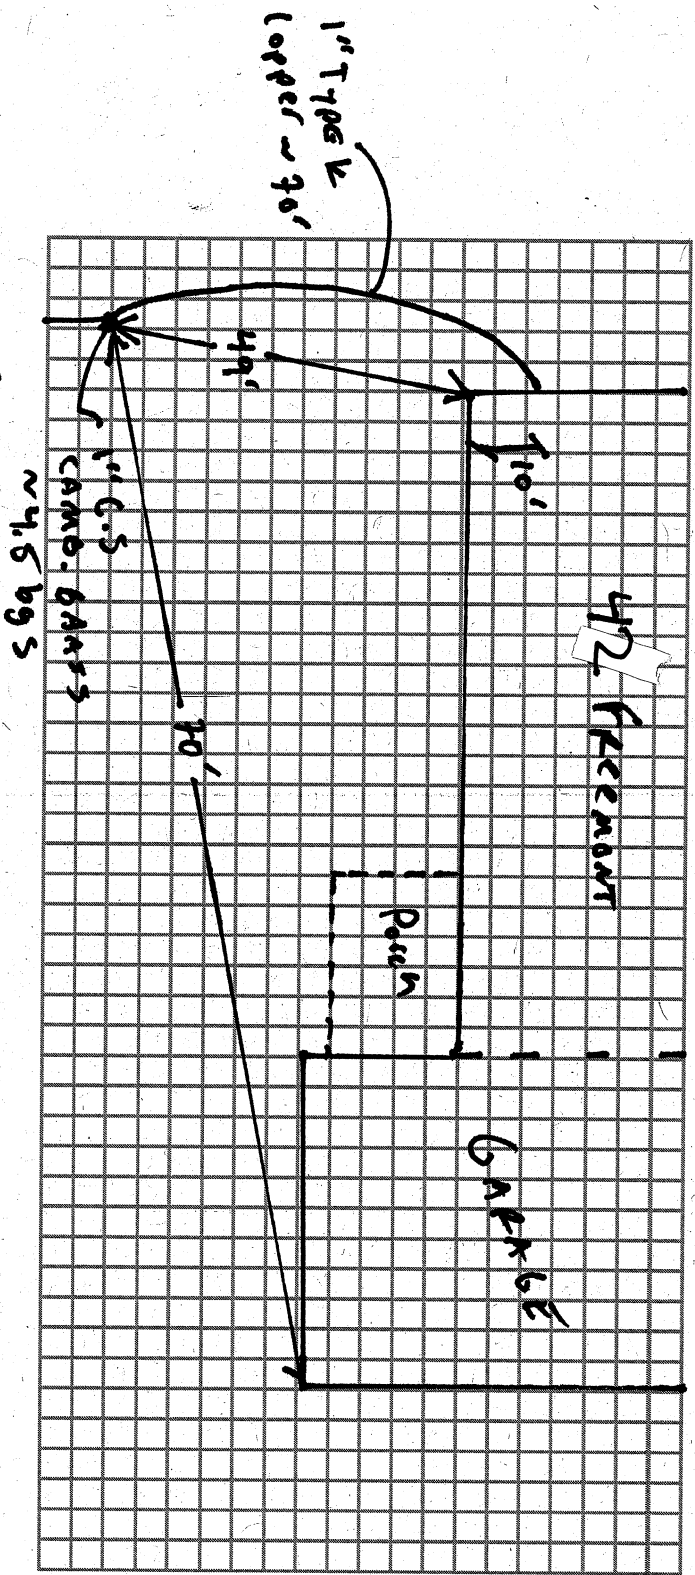

Connection made in: Freemont Street: Freemont Work completed:

Remarks: Freemont
Freemont
X 44 Freemont changed to 42 Freemont

