

3589, 3590

WATER SERVICE RECORD

Name Cyril Pratt

Service No. 45

Address 44 Freemont Street

Location Lots 630-634 Sta. 8+0

Repair—Renewal—New Service


Permit # 8 John E. Grant

Comm. 5-18-64

Date	Material	Amount	Total	Date	Amount
9-9-63	6' 3/4" Copper tubing @.42		2.52	5-5-64	Deposit 30.00
4-29-64	Installed by Contractor John E. Grant to house				NON CHARGE
				9-9-63	Labor 4.25
					23' 3/4" Copper tubing @.42 9.66
					1 3/4" C Corp Cock 4.91
					1 3/4" C Gurb Cock 6.28
					1 Box & Rod 4.90
					30.00

TOWN OF LEXINGTON — BOARD OF PUBLIC WORKS
WATER DIVISION

Sketch of Service Here

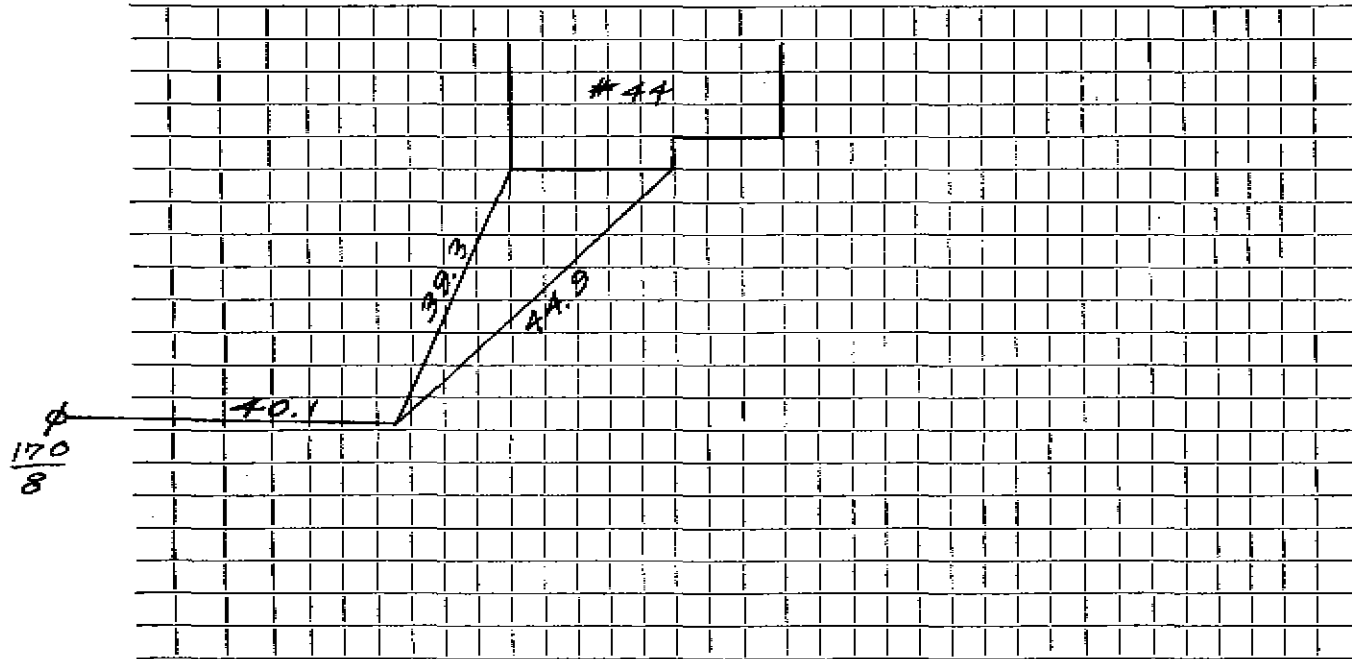

Connection made in Street. Work completed

Remarks:
.....
.....