

## WATER SERVICE RECORD

Name Paula Realty Trust

Service No. 135

Address 45 Fremont Street

Location Lots 212-213 Sta. 8+72

~~Reason - Renewal~~ New Service DeFlice Bros - Permit #154

DEC 28 1964


Date	Material	Amount	Total	Date	Amount
9/5/63	Labor	2 31		11-4-64	26 53
	10% O.H.	23	2 54		
	4' 3/4" Copper tubing @ .42		1 68		
			4 22		
			22 31	9/5/63	
			26 53	11'	3/4" Copper tubing @ .42
				1	3/4" C. Corp Cock
11-19-64	43' 3/4" Copper tubing			1	3/4" C. Curb Cock
				1	Box & Rod
					22 31
					26 53

22 31  
 4 22  
 26 53

DATE \_\_\_\_\_

**TOWN OF LEXINGTON — BOARD OF PUBLIC WORKS**  
**WATER DIVISION**

Sketch of Service Here

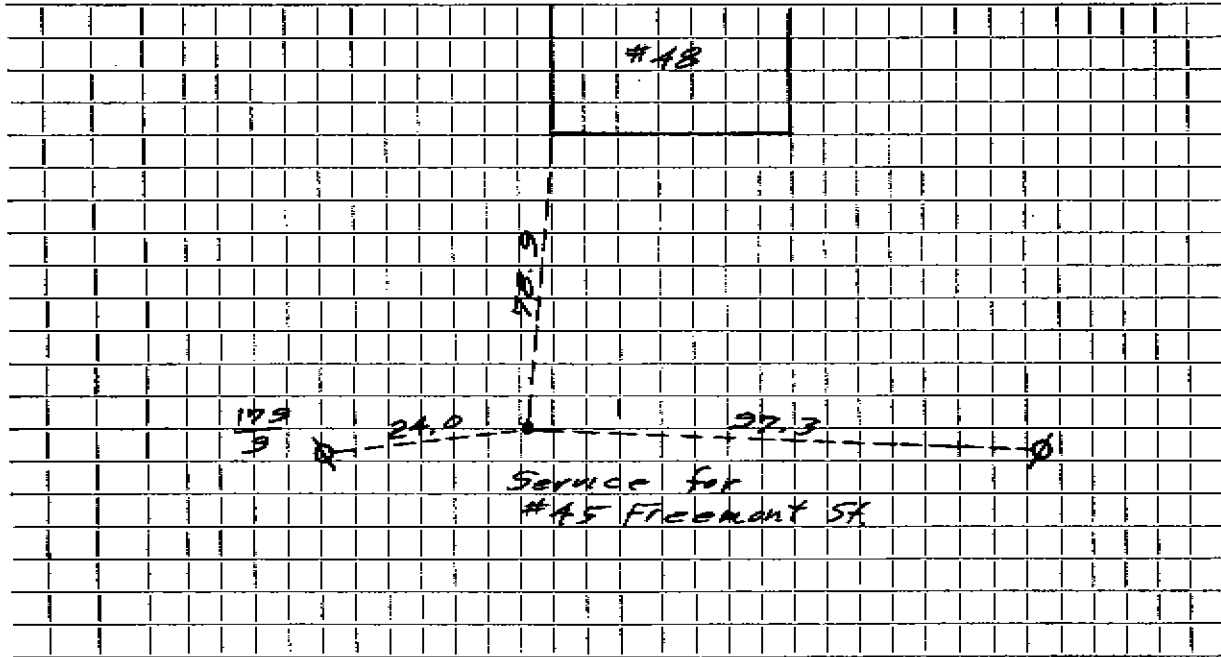

Connection made in ..... Street. Work completed .....

Remarks: .....

.....  
.....