

WATER SERVICE RECORD

1265
Service No.

#5983

124

Name Reginald Wood

Address 48 Freemont St.,

Location

X Repair X Renewal X New Service

#7204


Cenam 11-13-61

Date	Material	Amount	Total	Date		Amount
9/8/61	Labor	2 32		9-18-61	Deposit	50 0
	10% O.H.	<u>23</u>	2 55	11-13-61	Refund	36 24
						13 76
12 3/4"	Copper Tubing @ .42		5 04			
1 3/4" Cx 1/2 IWH Stop & Waste			<u>6 17</u>		NON SERVICE	
			13 76	9/8/61	Labor	1 61
					25 1/2" Copper Tubing @ .42	10 50
					1 3/4" C Corp Cock	4 91
					1 3/4" C Curb Cock	6 28
					1 Bow & Rod	4 90
					1 1/2" Straight Tail piece	50
					1 1/2" Offset Tailpiece	50
						29 20

DATE _____

TOWN OF LEXINGTON — BOARD OF PUBLIC WORKS
WATER DIVISION

Sketch of Service Here

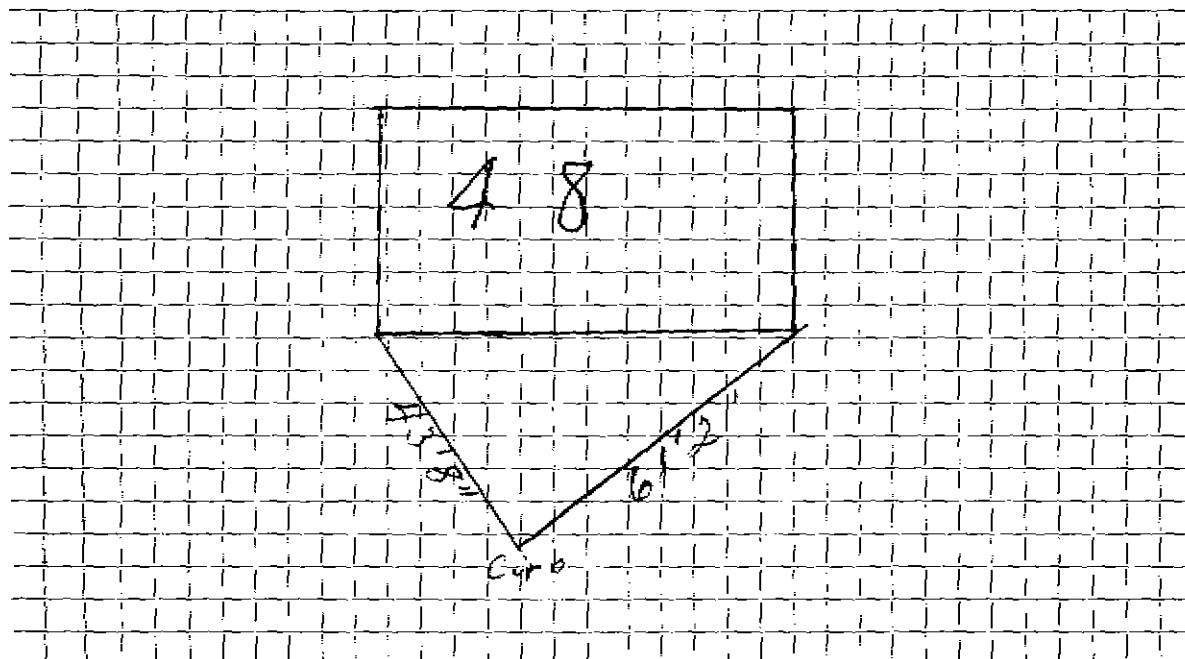

Connection made in Street. Work completed

Remarks:

.....
.....