

WATER SERVICE RECORD

2885 ✓

Name Paula Realty Trust

Service No. 20

Address 49 Fremont Street

Location Lots 215-217 Sta. 9+45

Repair—Renewal—New Service

MAY 17 1965


Date	Material	Amount	Total	Date	Amount
9-16-63	2' 3/4" Copper tubing @.42		84	4-8-65	31 97
	BILL WHEN CONNECTED		31 13		
			31 97		
5-12-65	40' 3/4" Transite pipe				
				9-16-63	4.96
					NON CHARGE
				24'	3/4" Copper tubing @.42 10.08
				1	3/4" C Curb Cock 6.28
				1	3/4" C Corp Cock 4.91
				1	Box & Rod 4.90
					31.13

DATE _____

TOWN OF LEXINGTON — BOARD OF PUBLIC WORKS

WATER DIVISION

Sketch of Service Here

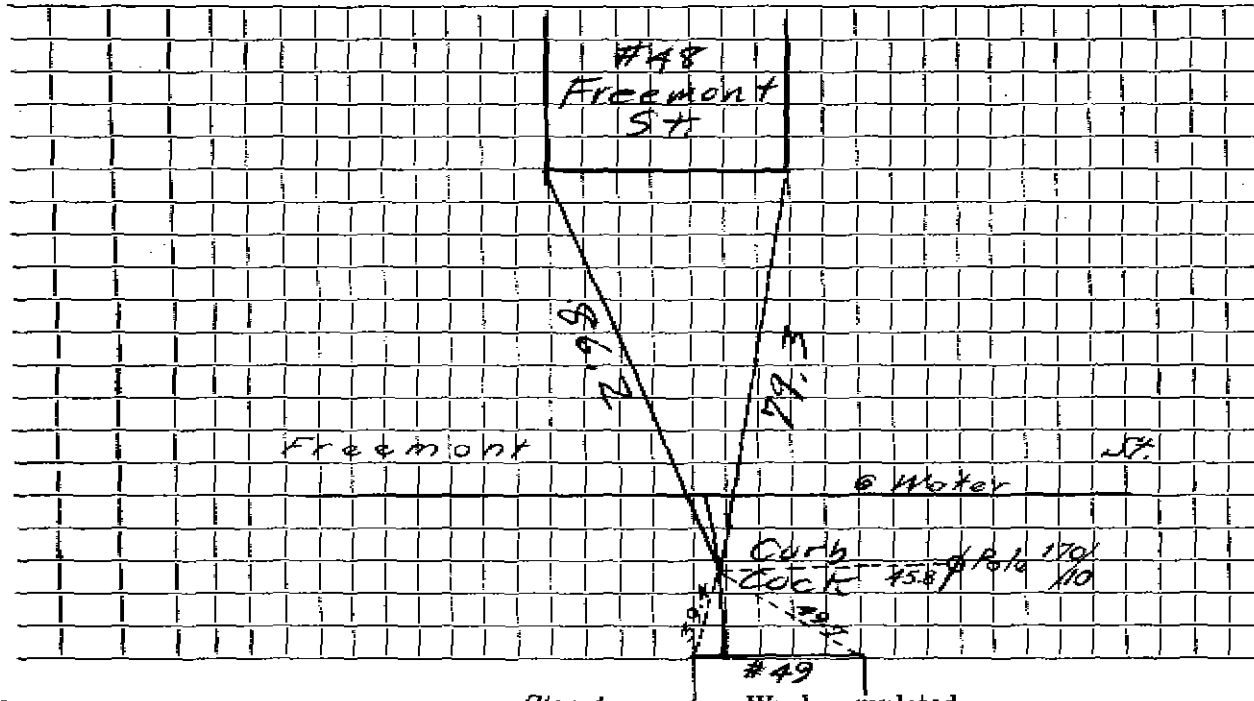

Connection made in Street. Work completed

Remarks:
.....
.....