

WATER SERVICE RECORD

Name Paula Realty Trust

Service No. 58

Address 53 Fremont Street

2094

Location

~~XXXXXX-XXXXXX~~ New Service W.O. #8041


Comm 10-28-63

Date	Material	Amount	Total	Date	Amount	
6-28-63	Labor	2 31		6-24-63	Deposit	50 00
	10% O.H.	23	2 54	10-28-63	Refund	9 48
	70' 3/4" Copper tubing @.42		29 40			40 52
	1 3/4" C 1/2 I.W.H. Stop & Waste		6 17			
	1 3/4" C3 Part Union		2 41		NON CHARGE	
			40 52	6-28-63	Labor	2 31
					6' 3/4" Copper tubing @.42	2 52
					1 3/4" C Corp Cock	4 91
					1 3/4" C Curb Cock	6 28
					1 Box & Rod	4 90
					1 1/2 Straight Tailpiece	50
					1 1/2 Offset Tailpiece	50
						21 92

DATE _____

TOWN OF LEXINGTON — BOARD OF PUBLIC WORKS
WATER DIVISION

Sketch of Service Here

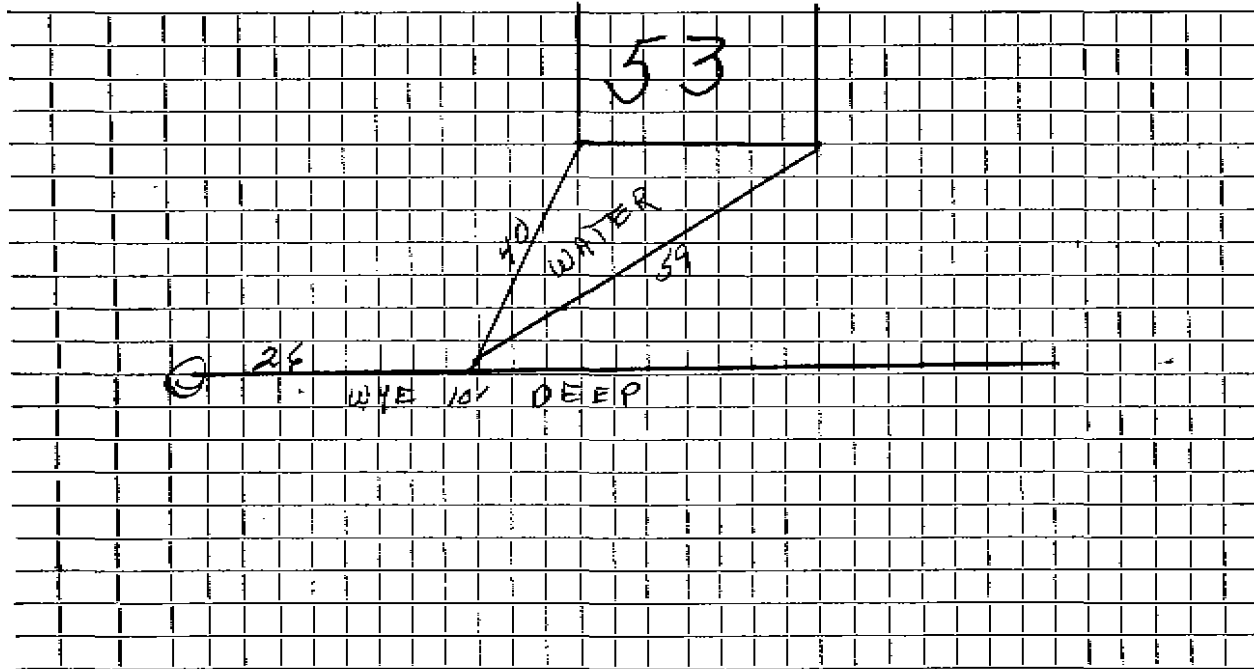

Connection made in Street. Work completed

Remarks:
.....
.....