

## WATER SERVICE RECORD

# 3648

Name Edward Baker

Service No. 105

Address 59 Freemont Street

Location

~~Repair - Renewal~~ New ServiceC<sup>o</sup> 8-1-60


Date	Material	Amount	Total	Date	Amount	
7-7-60	Labor	2 05		6-27-60	Deposit	50 00
	10% J.F.	21	2 26	2-1-60	Return	20 57
50'	3/4" Copper tubing @42		21 00			29 43
1	3/4" Cx $\frac{1}{2}$ I. L. P. Stop Waste		6 27			
			29 43		NCE CHARGE	
					Labor	1 75
					18' 3/4" Copper tubing @42	7 56
					1 3/4" C. Curb Cock	6 28
					1 3/4" C. Corp Cock	4 91
					1 Box & Rod	5 00
					1 $\frac{1}{8}$ Straight tailpiece	50
					1 $\frac{1}{8}$ Offset tailpiece	50
						26 50

DATE \_\_\_\_\_

TOWN OF LEXINGTON — BOARD OF PUBLIC WORKS

WATER DIVISION

Sketch of Service Here

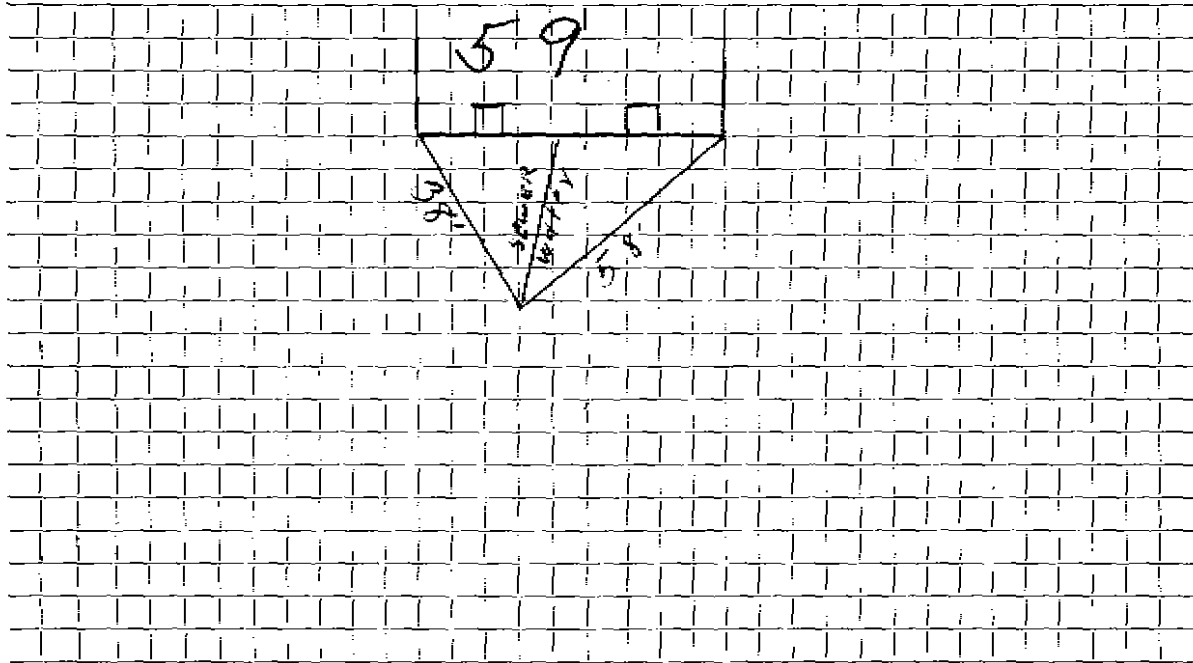

Connection made in ..... Street. Work completed .....

Remarks: .....  
.....  
.....