

WATER SERVICE RECORD

Name **Tricorn Homes**Service No. **2**Address **62 Freemont Street**

#7096

Location **Sta. 12+50 Lots 234-237**

Repair—Renewal—New Service

W.O.# 8461

MAR 23 1964


Date	Material	Amount	Total	Date	Amount	
1-10-64	Labor	4 73		1-6-64	Deposit	50 00
	10% O.H.	47	5 20	3-23-64	Returned	13 43
	60' 3/4" Copper Tubing @.42		25 20			36 57
	1 3/4" CX 1/2 I.W.H. Stop & Waste		6 17		NON CHARGE	
			36 57	9-17-63	Labor	2 42
					26' 3/4" Copper tubing @.42	10 92
					1 3/4" C Corp. Cock	4 91
					1 3/4" C Curb Cock	6 28
					1 Box & Rod	4 90
						29 43
				1-10-64	1 1/2 Straight Tailpiece	.50
					1 1/2 Offset Tailpiece	.50
						30 43

DATE _____

TOWN OF LEXINGTON — BOARD OF PUBLIC WORKS

WATER DIVISION

Sketch of Service Here

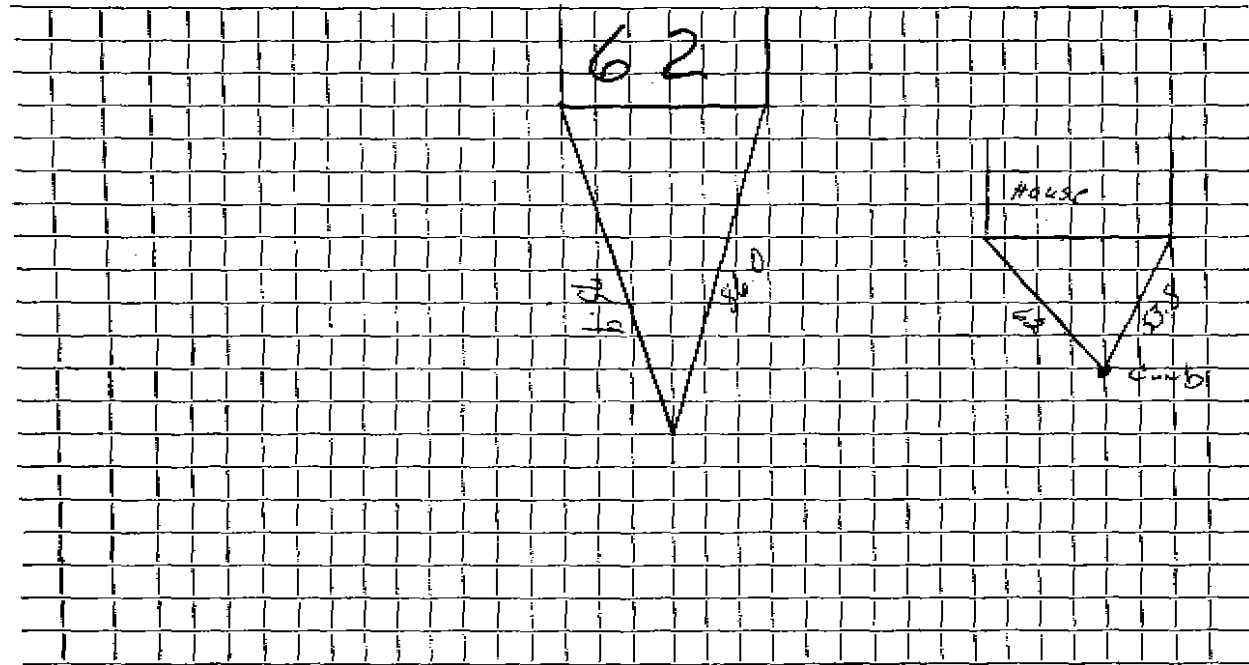

Connection made in Street. Work completed

Remarks:
.....
.....