

WATER SERVICE RECORD

1307

Name Leeland Construction

Service No. 74

Address 67 Freemont Street

Location Lot #62

~~Repair-Renewal~~ New Service

*Case 8-17-61*


Date	Material	Amount	Total	Date	Amount	
9-1-59	Labor	1.85		6-2-61	Deposit	100.00
	10% O.H.	.19	2.04	7-17-61	* Return	50.30
	8' 3/4" Copper tubing @.42	3.42	3.36			49.70
	<u>BILL WHEN CONNECTED</u>		<u>5.40</u>		NON CHARGE	
6-14-61	Labor	3.84		14'	3/4" Copper tubing @.42	5.88
	10% O.H.	.38	4.22	1	3/4" C Copper Cock	4.67
	75' 3/4" Copper Tubing @.42		31.50	1	3/4" C Curb Cock	5.98
	1 3/4" C x 1/2 I.W.H. Stop & Waste	6.17		1	Box & Rod	4.90
	1 3/4" C 3 part union	2.41	2.41			21.43
			49.70	6-14-61	1 1/2 Straight tailpiece	.50
					1 1/2 Offset tailpiece	.50
						22.43

\* Apply 43.44 to SPCA 46

TOWN OF LEXINGTON — BOARD OF PUBLIC WORKS

**WATER DIVISION**

Sketch of Service Here

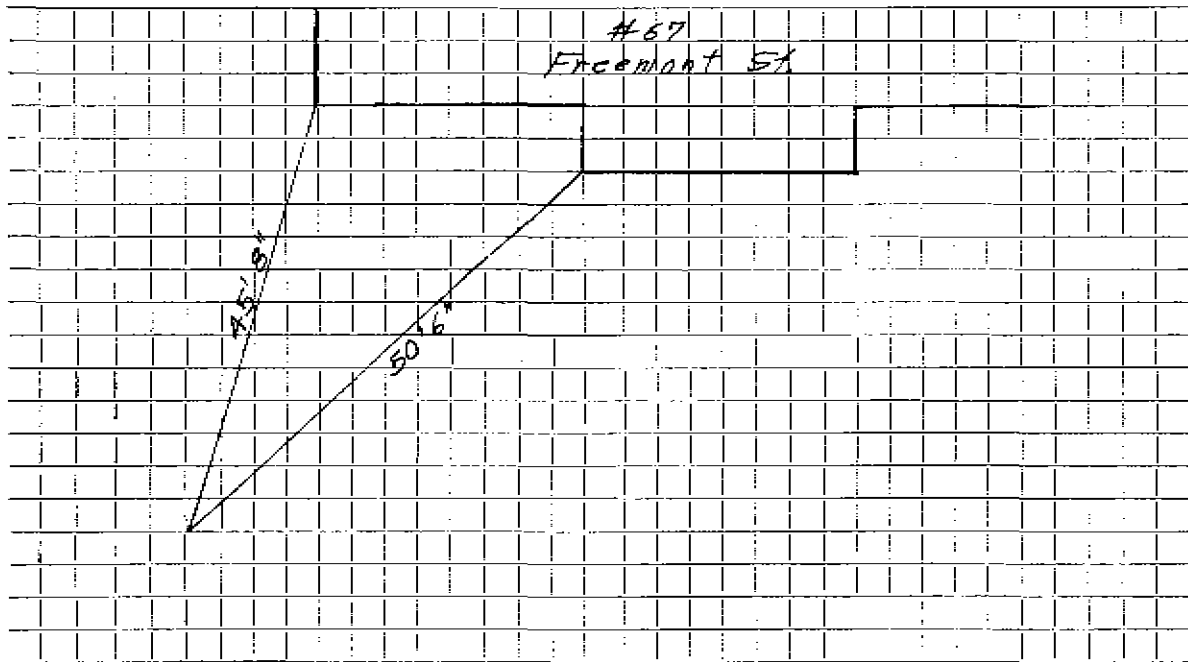

Connection made in ..... Street. Work completed .....

Remarks: .....

.....

.....