


DATE 11/2/2020

TOWN OF LEXINGTON — BOARD OF PUBLIC WORKS
WATER DIVISION

Sketch of Service Here

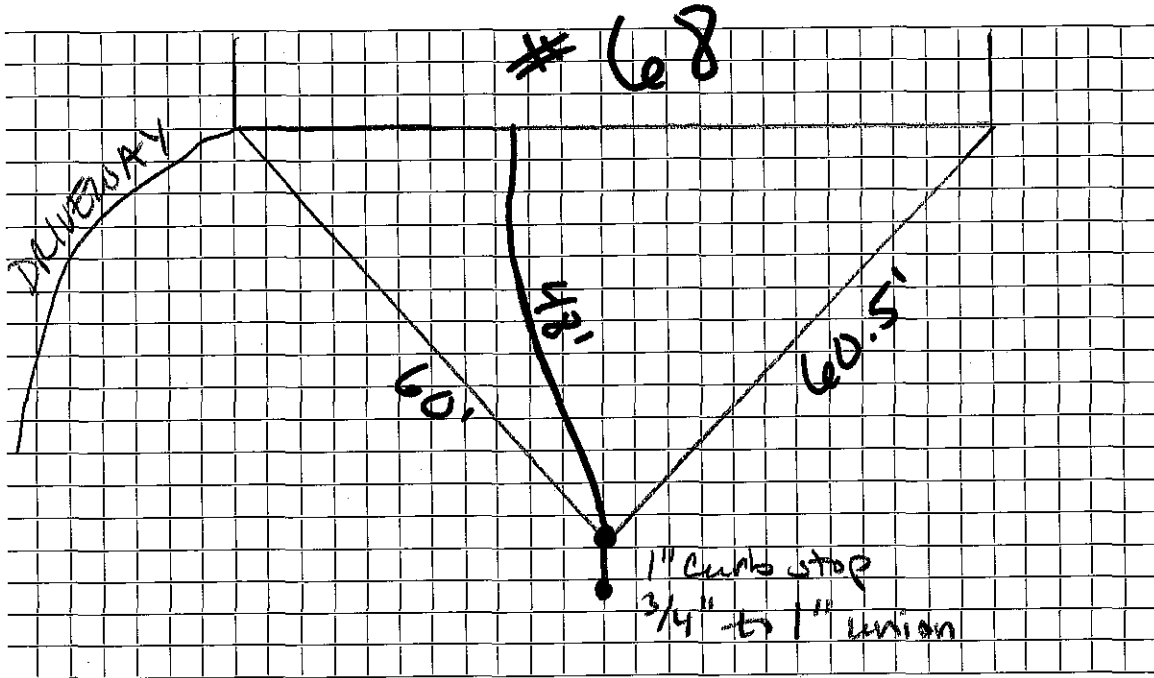

Connection made in freemont Street. Work completed

Remarks: 5' cover