

## WATER SERVICE RECORD

Name Leeland Construction Co.

Service No. 153

Address 69 Fremont Street

Location Lot #61

~~Repair - Renewal~~ - New Service


Comm 12-4-61

Date	Material	Amount	Total	Date	Amount
9-1-59	Labor	1.85		10-9-61	100.00
	10% O.H.	.19	2.04	12-4-61	41.71
	12' 3/4" Copper tubing @ .42		5.04		58.29
	BILL WHEN CONNECTED		7.08		NON CHARGE
10/19/61	Labor	3.73		9' 3/4" Copper tubing @ .42	3.78
	10% O.H.	.37	4.10	1 3/4" C Corb Cock	4.67
	86' 3/4" Copper Tubing @ .42		36.12	1 3/4" C Curb Cock	5.98
	1 3/4" C x 1/2 IWH Stop & Waste		6.17	1 Box & Rod	4.90
	2 3/4" CS part Union @ 2.41		4.82		19.33
			58.29	10/19/61 1 1/2 Straight Tailpiece	50
				1 1/2 Offset Tailpiece	50
					20.33

TOWN OF LEXINGTON — BOARD OF PUBLIC WORKS

**WATER DIVISION**

Sketch of Service Here

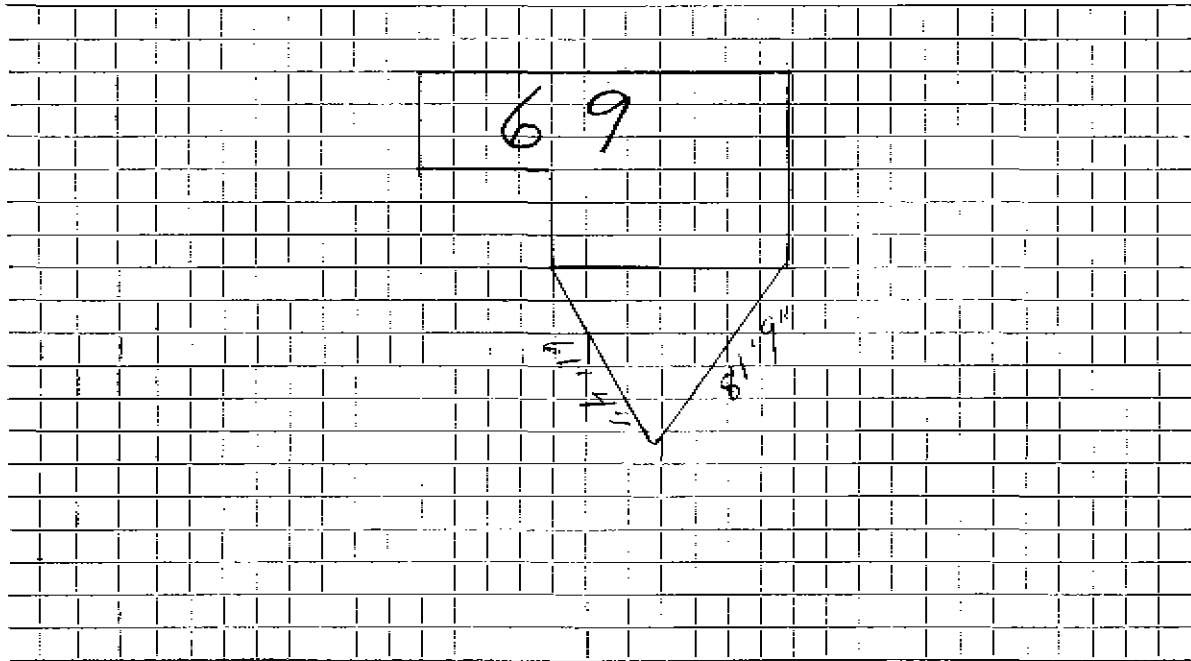

Connection made in ..... Street. Work completed .....

Remarks: .....

.....

.....