

1333

WATER SERVICE RECORD

Name Leeland Construction

Service No. 15

Address 70 Freemont Street

Location Lot #64

~~Repair~~ ~~Renewal~~ New Service


Comm 6-16-61

Date	Material	Amount	Total	Date	Amount	
9-1-59	Labor	1.85		3-30-61	Deposit	35.00
	10% O.H.	.19	2.04	6-29-61	Paid	33.14
	12' 3/4" Copper tubing @.42		5.04			68.14
	BILL WHEN CONNECTED		7.08		NON CHARGE	
4-25-61	Labor	1.89		34'	3/4" Copper tubing @.42	14.28
	10% O.H.	.19	2.08	1	3/4" U Corp Cock	4.67
	120' 3/4" Copper Tubing @.42		50.40	1	3/4" U Curb Cock	5.98
	1 3/4" C x 1/8" I.W.H. Stop & Waste	6.17		1	Box & Rod	4.90
	1 3/4" c 3 part union		2.41			29.83
			68.14	4-25-61	1 1/2" Straight tailpiece	.50
					1 1/2" Offset tailpiece	.50
						30.83

TOWN OF LEXINGTON — BOARD OF PUBLIC WORKS

WATER DIVISION

Sketch of Service Here

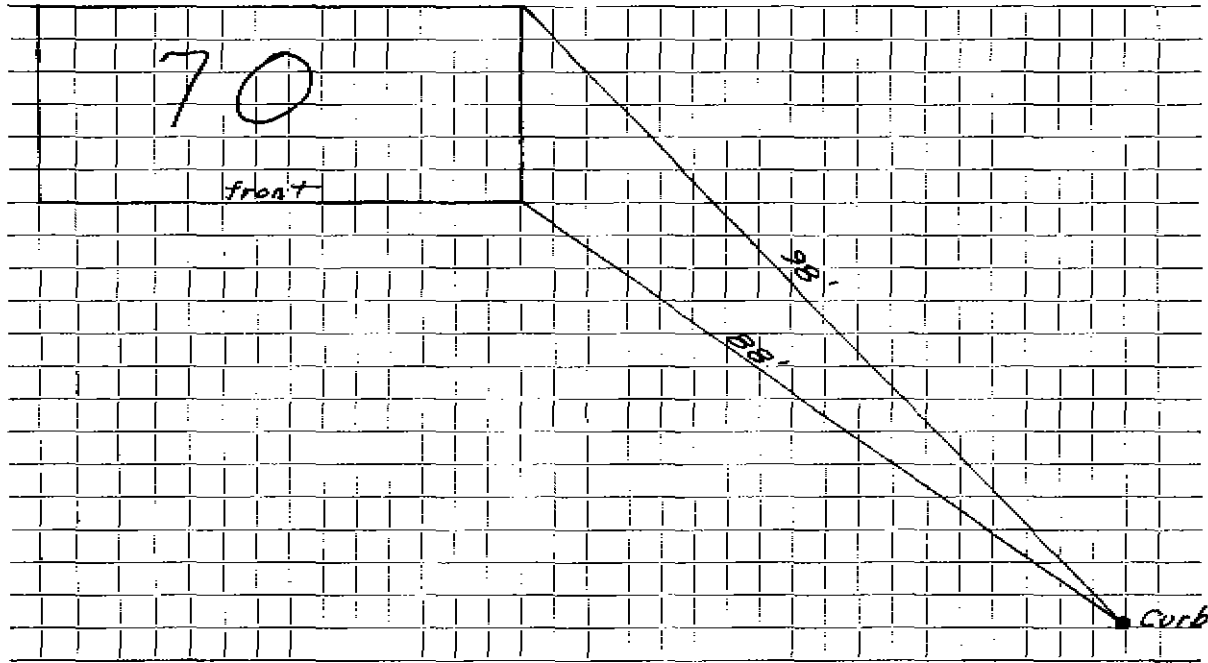

Connection made in Street. Work completed

Remarks:
.....
.....