

WATER SERVICE RECORD

4404
Service No. 16

Name Leeland Construction

Address 72 Freemont Street

Location

~~Repair~~ ~~Work~~ - New Service

Comm 6-16-61


Date	Material	Amount	Total	Date	Amount	
4-26-61	Labor	22.74		3-30-61	Deposit	35.00
	10% O.H.	2.27	25.01	6-16-61	Paid by SH# 16	39.39
90'	3/4" Copper Tubing @.42	37.80			NON CHARGE	24.39
1	3/4" C x 1/2 I.W.E. Stop & Waste	6.17	4-26-61	1 1/8 Offset tailpiece	.50	
1	3/4" c 3 part union	2.41		1 1/2 Straight tailpiece	.50	
1	Fr. Trucking @3.00	3.00			1.00	
			74.39			

DATE _____

TOWN OF LEXINGTON — BOARD OF PUBLIC WORKS

WATER DIVISION

Sketch of Service Here

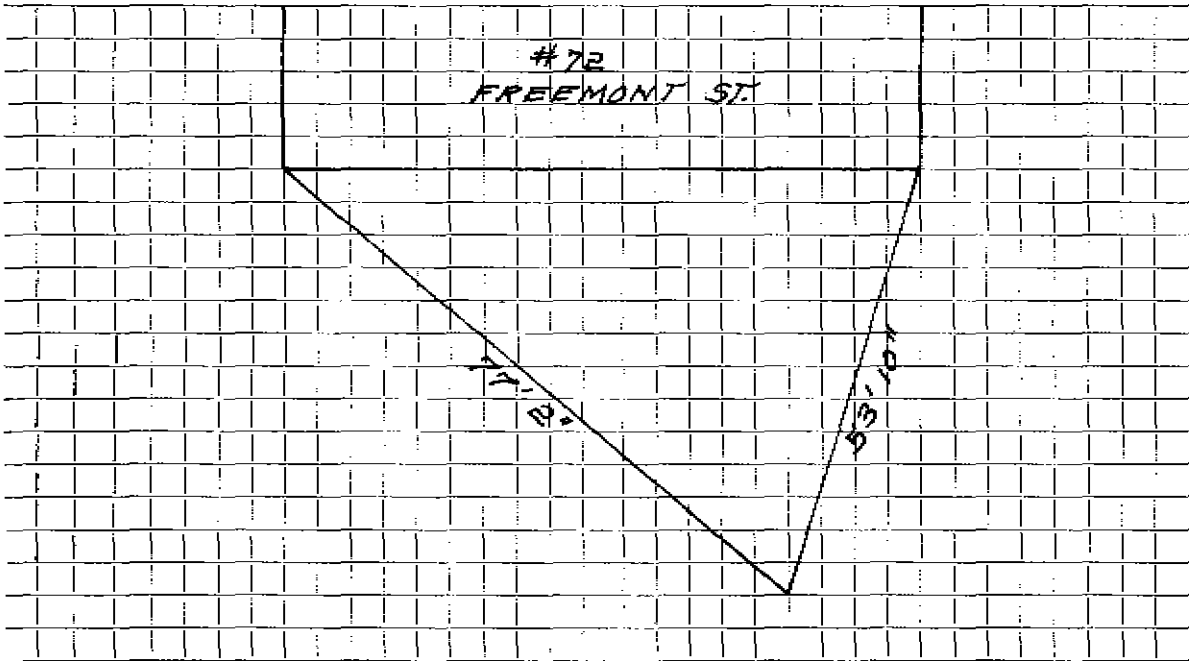

Connection made in Street. Work completed

Remarks:

.....

.....