

WATER SERVICE RECORD

Name Richard HamiltonService No. 204Address 8 Freemont Street# 452

Location

~~Repair~~ ~~Renewal~~ New Service*Comm 11-21-60*


Date	Material	Amount	Total	Date	Amount
10-5-60	Labor	2 05		<i>9-22-60</i>	<i>Deposit</i> 50 00
	10% O.H.	<u>21</u>	2 26	<i>11-21-60</i>	<i>Returned</i> <u>21 09</u>
	44' 3/4" Copper tubing @42		18 48		<u>29 91</u>
	1 3/4" Cx 1/2 I.W.H. Stop & Waste		6 17		
	1 Hr. Trucking @5.00		<u>3 00</u>		NON CHARGE
			29 91	10-5-60	Labor 1 94
					18' 3/4" Copper tubing @42 7 56
					1 3/4" C Corp Cock 4 91
					1 3/4" C Curb Cock 6 28
					1 Box & Rod 4 90
					1 1/2 Straight tailpiece 50
					1 1/2 Offset tailpiece <u>50</u>
					26 59

DATE _____

TOWN OF LEXINGTON — BOARD OF PUBLIC WORKS

WATER DIVISION

Sketch of Service Here

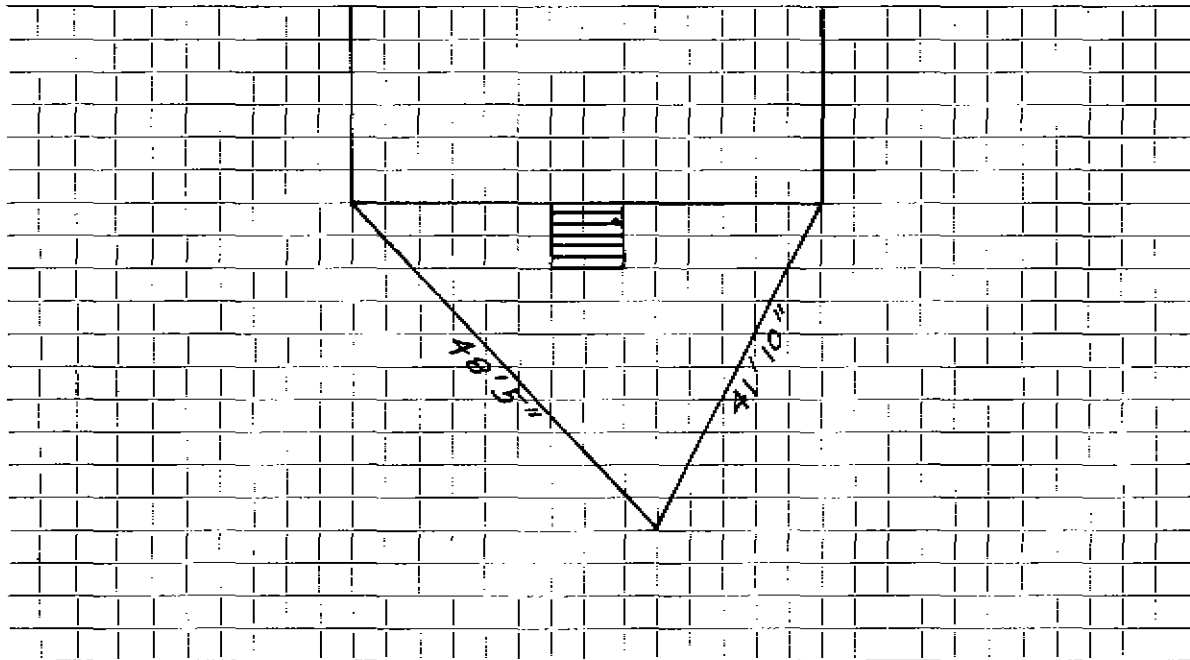

Connection made in Street. Work completed

Remarks:

.....

.....