

WATER SERVICE RECORD

Name Custom Colonials, Inc.

Service No. 312

Address 9 Freemont Street

Location

~~Repair or Renewal~~ - New Service

Comm 2865


Date	Material	Amount	Total	Date	Amount
12-3-59	Labor	2 01		11-25-59	25 00
	10% O. H.	20	2 21	12-18-60	5 93
	47' 3/4" Copper tubing @.42		22 09		30 93
	1 3/4" C x 1/8" I.W.H. Stop & Waste	5 88			NON CHARGE
	1 Hr. Trucking		75	12-3-59	Labor 1 61
			30 93		9' 3/4" Copper tubing @.42 3 78
					1 3/4" C Curb Cock 5 98
					1 3/4" C Corp Cock 4 67
					1 Box & Rod 5 00
					1 1/2" Straight Tailpiece 50
					1 1/2" Offset Tailpiece 50
					22 04

DATE _____

TOWN OF LEXINGTON — BOARD OF PUBLIC WORKS

WATER DIVISION

Sketch of Service Here

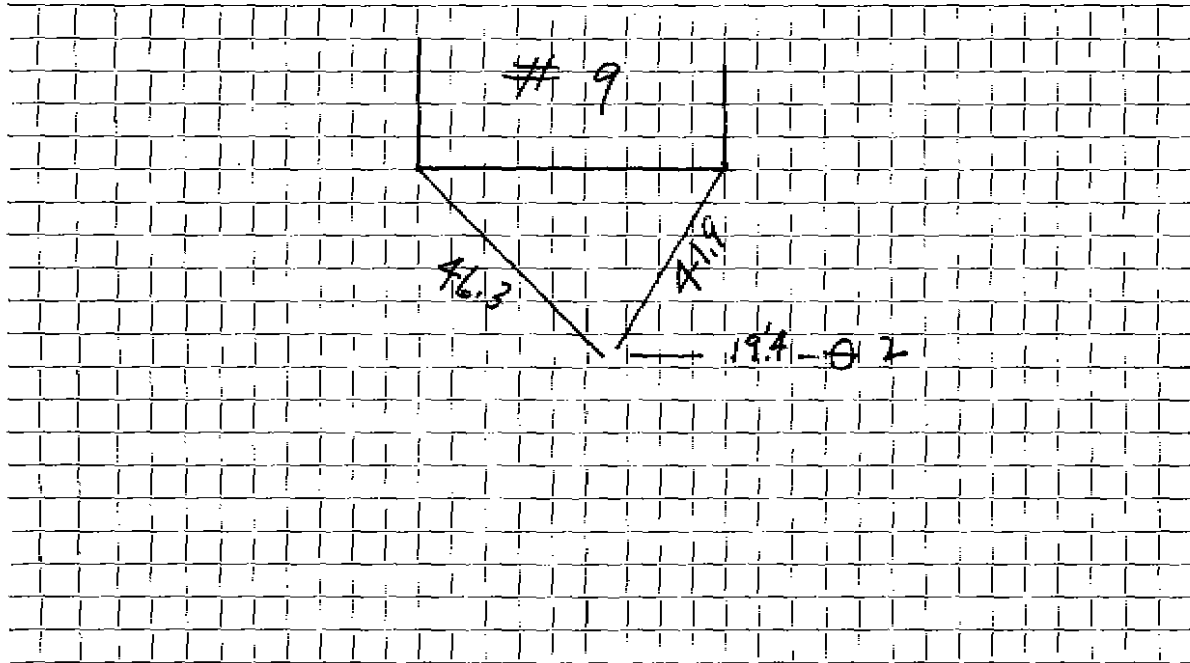

Connection made in Street. Work completed

Remarks:
.....
.....