




DATE \_\_\_\_\_

TOWN OF LEXINGTON — BOARD OF PUBLIC WORKS

**WATER DIVISION**

Sketch of Service Here

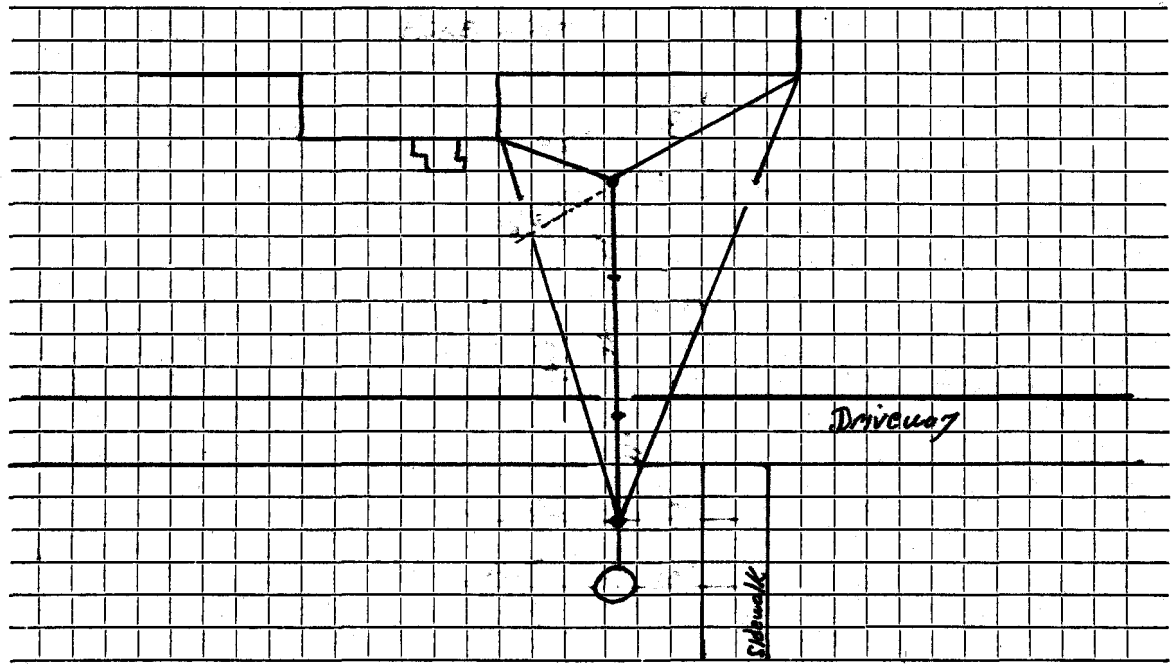

*Adams St.*

Connection made in ..... Street.      Work completed .....

Remarks: .....

.....

.....