

## WATER SERVICE RECORD

Name Foley Realty Trust

Service No.

Address 1 Frost Road

Location

Repair—Renewal—New Service DeFlice Bros. Permit #A260

Date	Material	Amount	Total	Date	Amount
6/9/66	100' 3/4" Copper tubing			6-64	
				<del>28 3/4" Copper</del>	
				10/30/62	
				21' 1" Copper	
				1 1" Corp	
				1 1" Coulb	
				1 Buffalo box	
				1 x 3/4 Red.	


DATE \_\_\_\_\_

TOWN OF LEXINGTON — BOARD OF PUBLIC WORKS

WATER DIVISION

# 1 Frost Rd

Sketch of Service Here

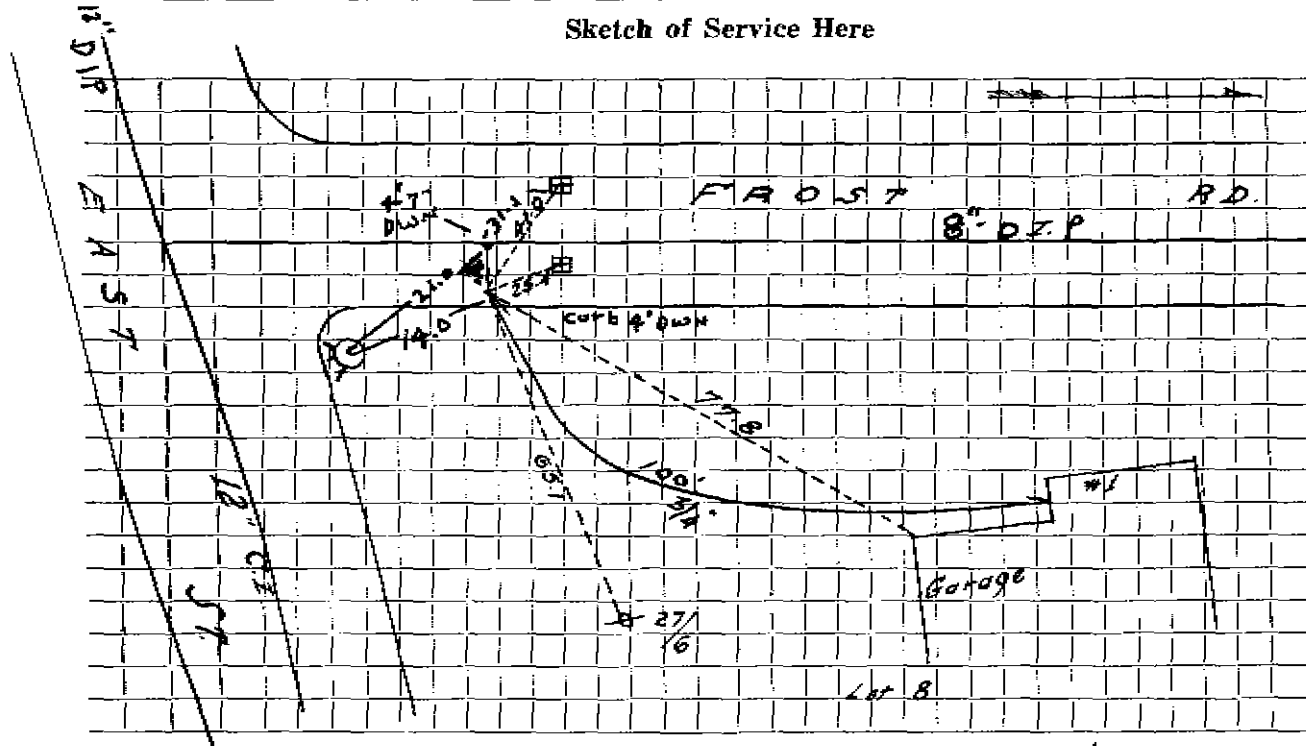

Connection made in ..... Street. Work completed 10/2002 NEW 8" D.I.P. ....

Remarks: .....

.....

.....