


WATER DIVISION

Sketch of Service Here

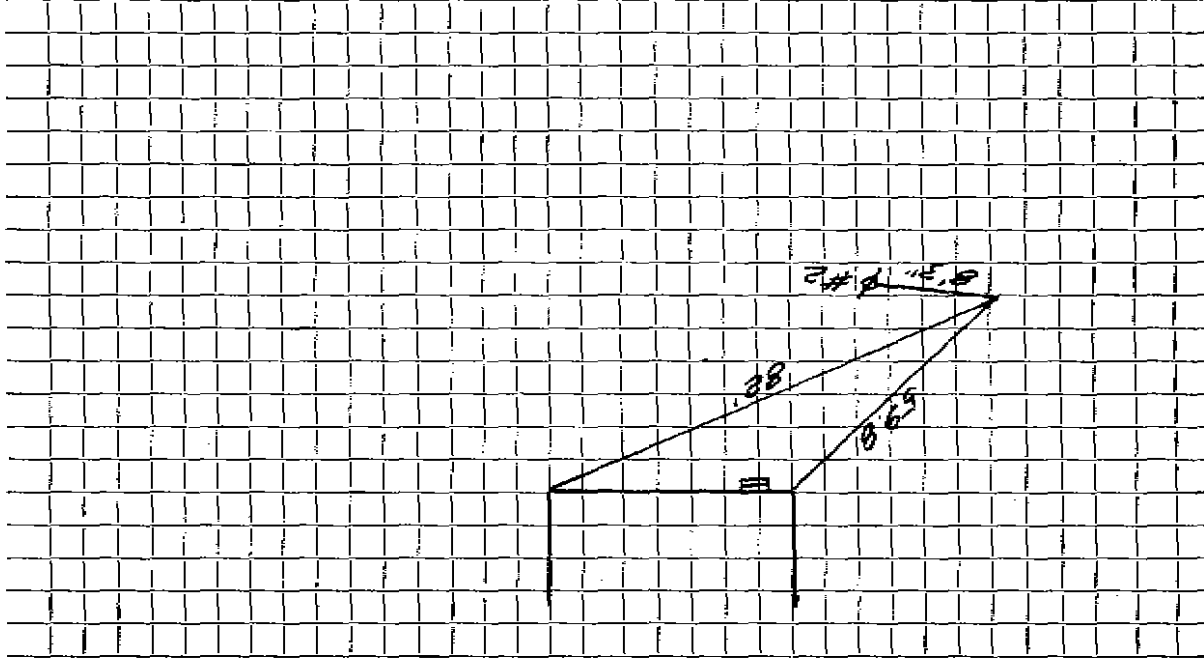

Connection made in _____

Street _____


Work completed _____

Remarks: _____

DATE _____

TOWN OF LEXINGTON — BOARD OF PUBLIC WORKS
WATER DIVISION

Sketch of Service Here
Frost RD.

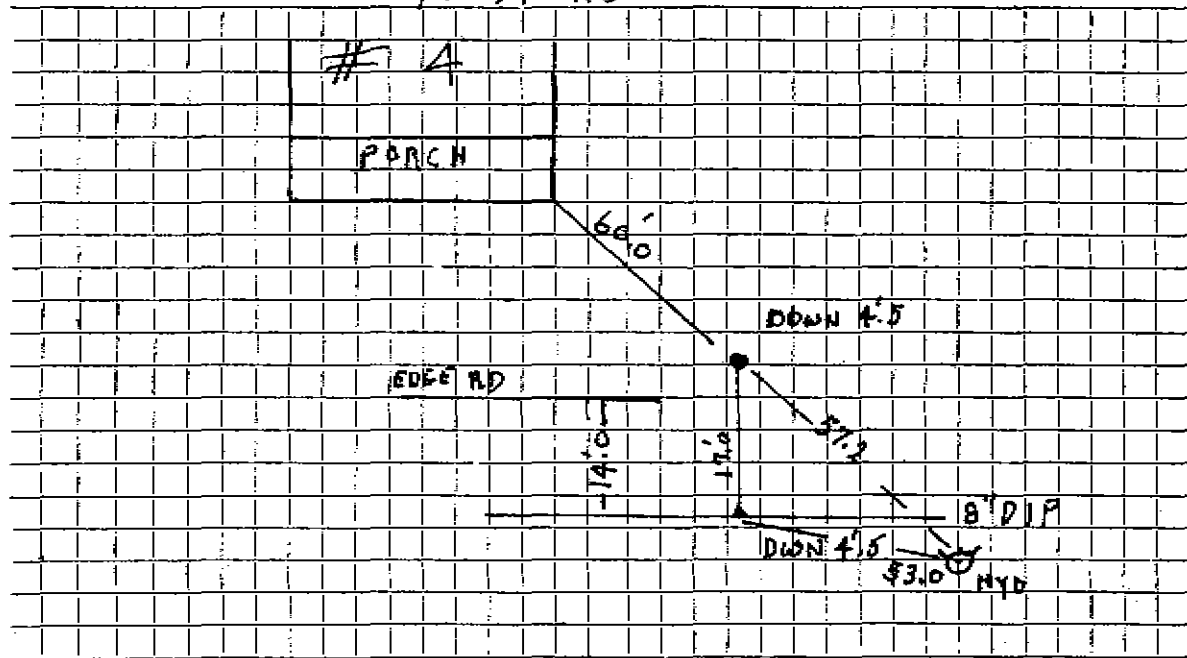

Connection made in Street. Work completed 10/02

Remarks: new 8" D.I.P.