




DATE \_\_\_\_\_

TOWN OF LEXINGTON — BOARD OF PUBLIC WORKS

WATER DIVISION

Sketch of Service Here  
FROST RD

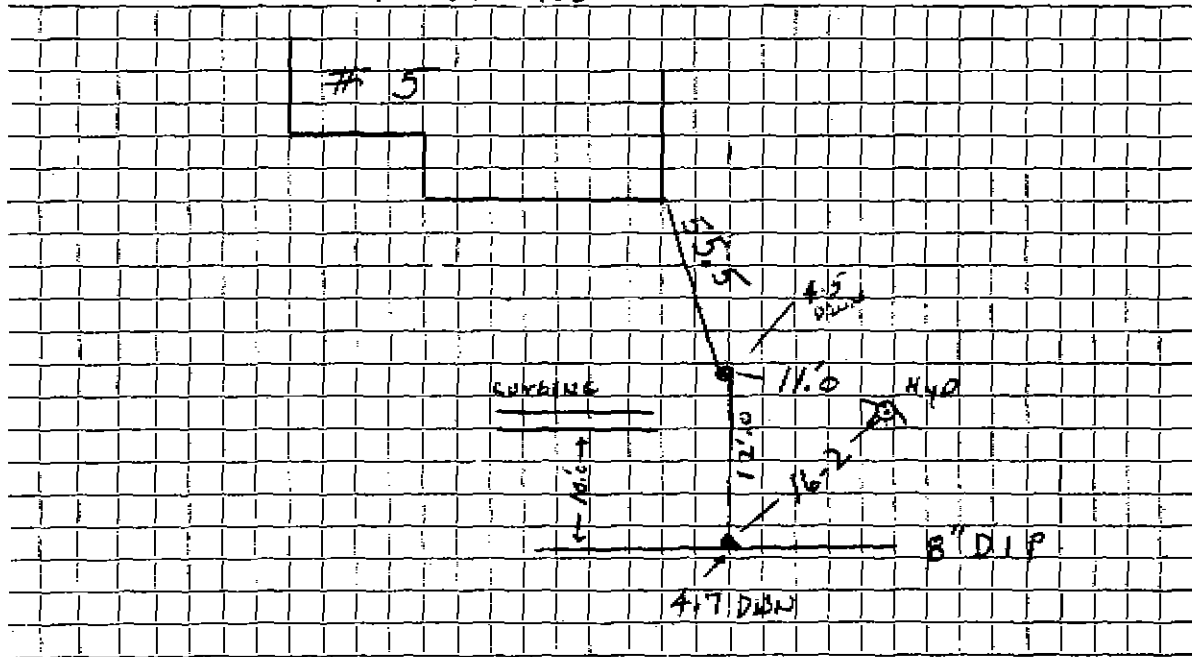

Connection made in ..... Street. Work completed 2002.....

Remarks: .....

.....

.....