


DATE _____

TOWN OF LEXINGTON — BOARD OF PUBLIC WORKS

WATER DIVISION

Sketch of Service Here
Frost RD

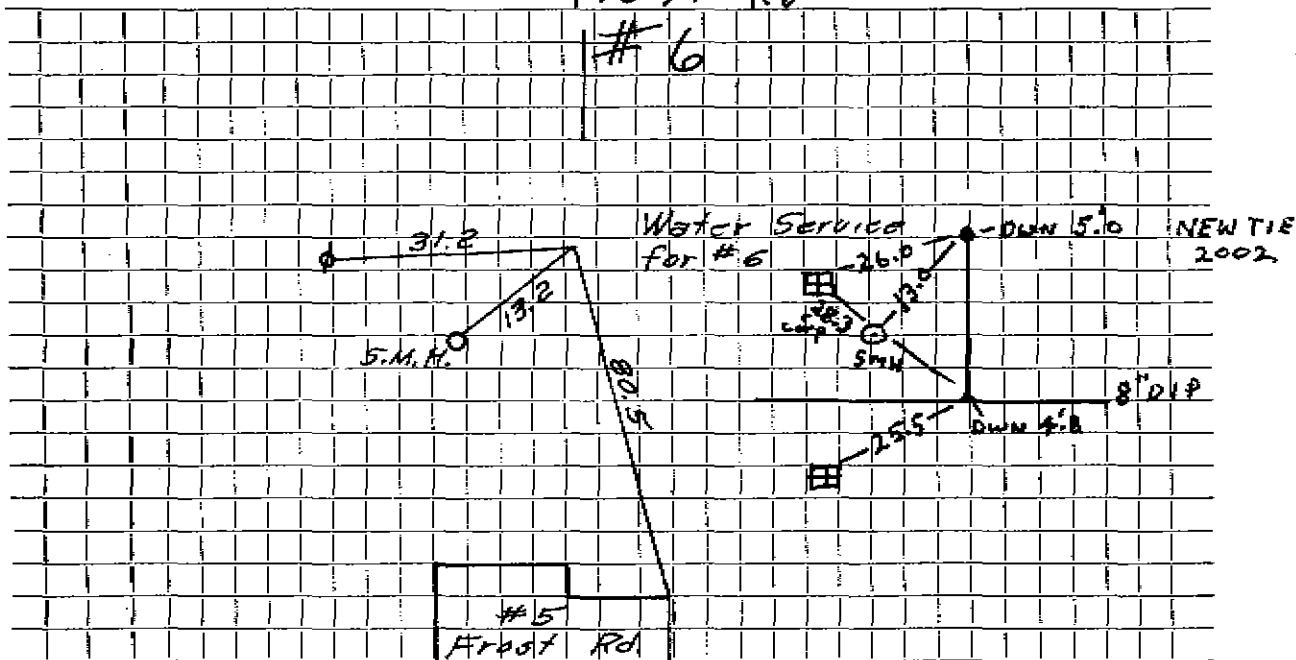

Connection made in _____ Street.

Work completed 10/2002

Remarks: _____