




DATE

TOWN OF LEXINGTON — BOARD OF PUBLIC WORKS

WATER DIVISION

Sketch of Service Here

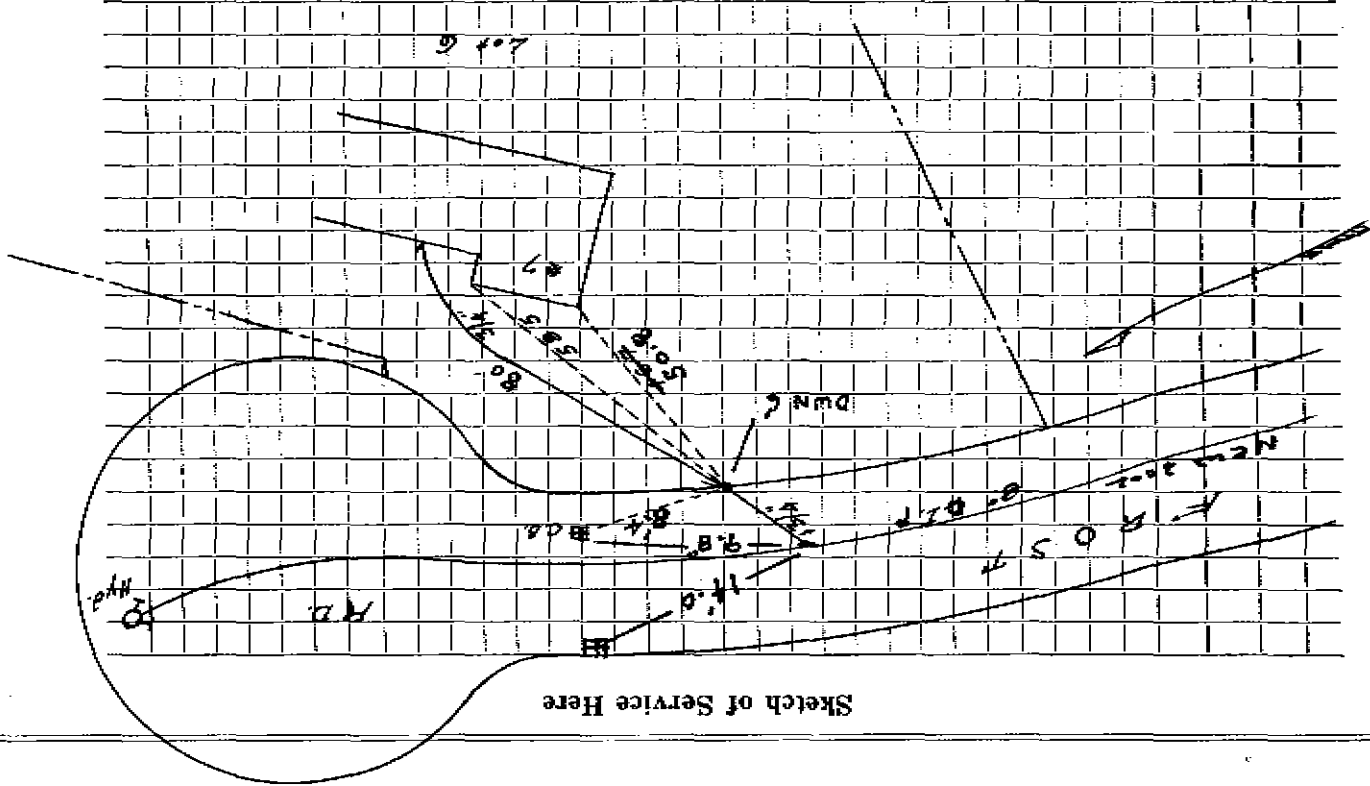

Connection made in

Street.

Work completed

10/2002

Remarks: