




TOWN OF LEXINGTON — BOARD OF PUBLIC WORKS  
WATER DIVISION

Sketch of Service Here  
# 8 Frost RD

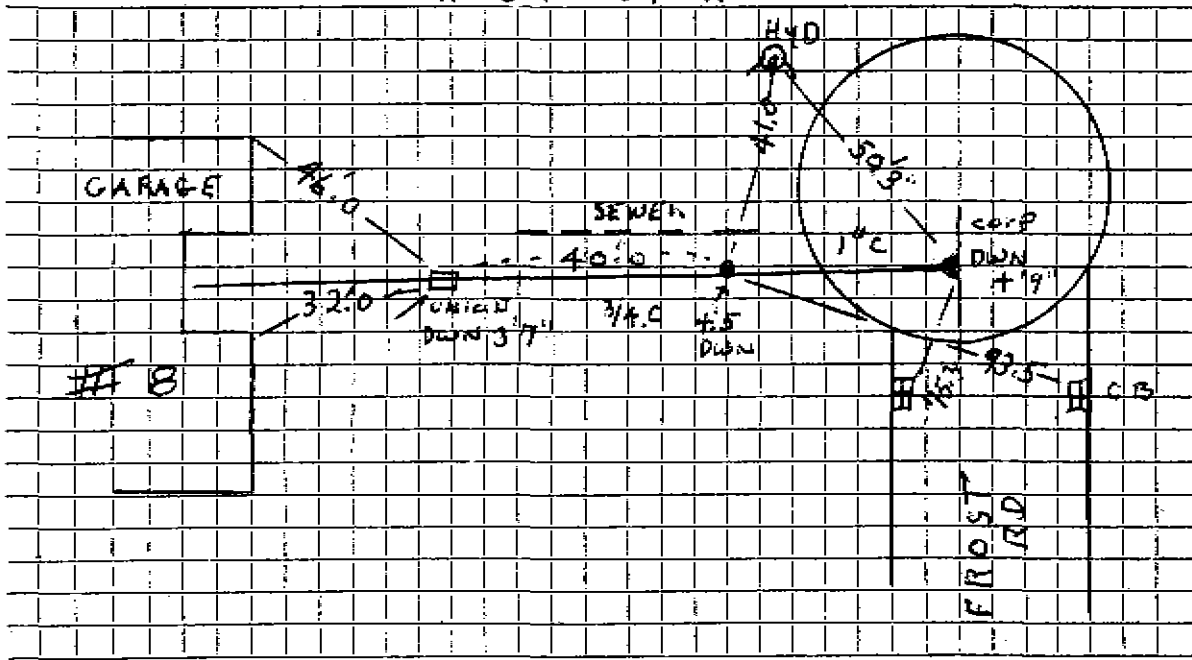

Connection made in ..... Street. Work completed ..10/2002 NEW 8" D.I.P.....

Remarks: SEWER IN SAME TRENCH. WATER CROSSES OVER SEWER AT UNION.....