

Name S. M. Nelson  
 Address 39 Bridge Street

Service No. # 994  
 # 2479

Location 1 Fuller Road.

Kind of Pipe Size Size of Main

Repair—Renewal—New Service

Location

Date	Material	Amount	Total	Date	Amount
1937					
Oct. 25,	2 hrs @ 80¢	1 80		Sept 30, 1937	16 00
<del>26.10 26.30</del>	10, overhead	12	1 32	Deposited	
	33' 3/4" Cop. Tub. @ 25¢	8 25	3 25	Nov. 19, 1937	50
	1 3/4" S. & S.	3 75	3 75	Paid	16 50
	2 hrs. trucking @ 75¢	1 50	1 50		
			<u>14 82</u>		
	Flat Rate:				
	33' @ 50¢		<u>\$16 50</u>		
	Labor				

Indley Press, Inc., Lexington

# TOWN OF LEXINGTON—BOARD OF PUBLIC WORKS

## WATER DIVISION

The undersigned applies for a supply of water at No. 17 St. and hereby agrees to comply with the rules and regulations as now, or at any future time, established by the Board of Selectmen.

Am't. of Estimate \$ 500

Owner

Lucas M. Jackson

Am't. Paid \$ \_\_\_\_\_


Address

39 Bridge St

Lexington

Builder \_\_\_\_\_

Sketch of Service Here

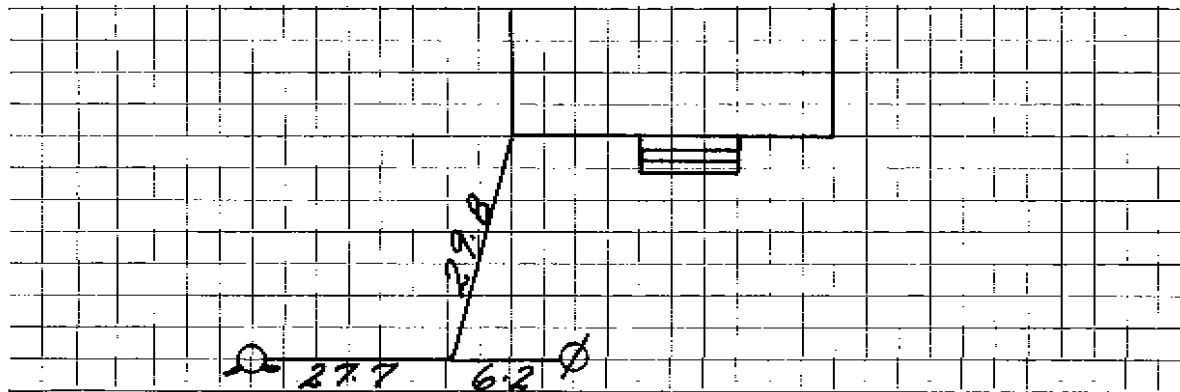

Connection made in \_\_\_\_\_ Street.

Work completed \_\_\_\_\_ 19

Remarks: