

Name H. Tobiason
 Address 191 Newport Street, Arlington, Mass.

1467
 Service No. ~~33~~ 997
 # 0000

Location 25 Fuller Road

Kind of Pipe
 Size
 Size of Main
 Repair—Renewal—New Service
 Location

Date	Material	Amount	Total	Date	Amount
Nov. 18, 1940	8 hrs. @ 60¢	4 80		November 19, 1940 Deposited	16 00
<i>Com 12-31-40</i>	10% Overhead	48	5 28		
	39' 3.4" Copper tubing	19 41	7 41		
	1 3/4" C.S. & W.		2 25		
	2 hrs. trucking @ 75¢		1 50		
	63X		<u>\$16 44</u>		
	Charge \$16.00				
	Labor				

Judloy Press, Inc., Lexington

DATE Oct 31, 1948

TOWN OF LEXINGTON—BOARD OF PUBLIC WORKS WATER DIVISION

The undersigned applies for a supply of water at No. 75 Fuller Road St. and hereby agrees to comply with the rules and regulations as now, or at any future time, established by the Board of Selectmen.

Am't. of Estimate \$ 16⁰⁰


Am't. Paid \$ _____

Builder: N. Tahison
Owner

Address 191 Newport St.
Arlington Mass.

Owner G. P. Langton
Builder

Sketch of Service Here

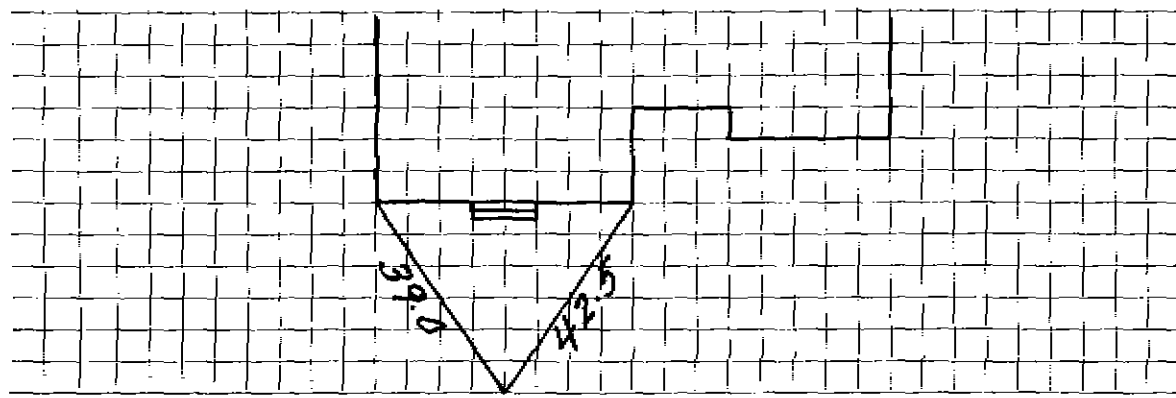

Connection made in _____ Street.

Work completed _____ 19

Remarks: