

Name Edward Palmer
 Address 36 Fuller Road
 Lexington, Mass.

Service No. ⁶⁰ 3304

Location 36 Fuller Road

Kind of Pipe Size Size of Main
~~Repair - Renewal~~ - New Service Location

Date	Material	Amount	Total	Date	Amount
Jul. 16, '47	Labor	21 00	21 00	July 15 '47	50 00
	10% Overhead		2 10	Sept 23 '47	8 69
	53' - 3/4" Copper Tubing @ .27		14 31		41 31
	1 - 3/4" C x 3/4" I.W.B. S & W		3 15	Jul. 16, '47	22 05
	Trucking 1 hr. @ .75		75	15' - 3/4" Copper Tubing @ .27	4 05
			41 31	1 - 3/4" C Corp-cock	3 00
				1 - 3/4" C x 3/4" C Curb-cock	3 68
				1 - Box & Rod	4 25
				1 - 3" Straight Tail Piece	30
				1 - 3" Offset Tail Piece	30
				Trucking 1 hr. @ .75	75
					38 39
	Labor				

Deposited
Refunded
 Non-Charge

Hadley Dress, Inc., Lexington

TOWN OF LEXINGTON—BOARD OF PUBLIC WORKS

WATER DIVISION

The undersigned applies for a supply of water at No. _____ St. and hereby agrees to comply with the rules and regulations as now, or at any future time, established by the Board of Selectmen.

Am't. of Estimate \$ _____


Owner _____

Am't. Paid \$ _____

Address _____

Builder _____

Sketch of Service Here

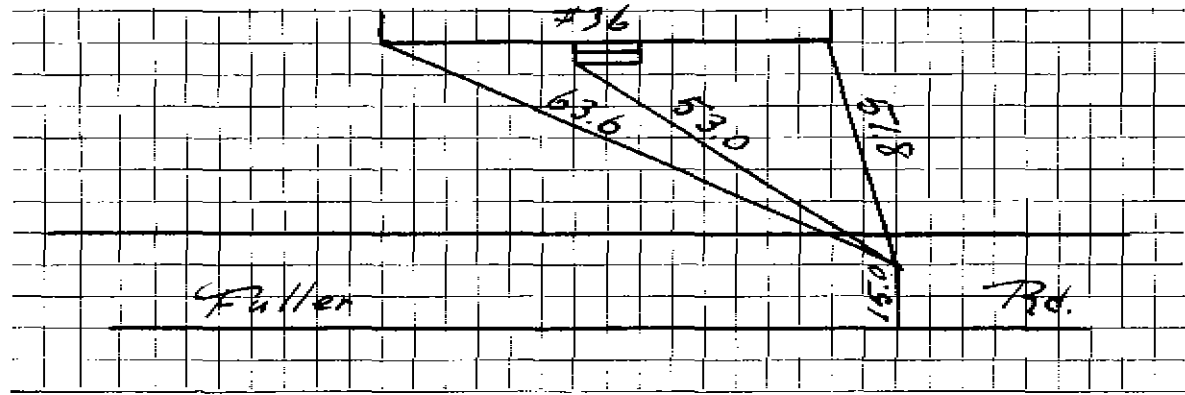

Connection made in _____ Street.

Work completed _____ 19__

Remarks: