

WATER SERVICE RECORD

Name

Service No.

Address

9 Fuller Road


Location

Repair—Renewal—New Service

Date	Material	Amount	Total	Date	Amount
8/4/31	41' 1" C.L. Pipe				
	2 1" L.L. Coup.				
NON CHARGE					
Sept 15, 1999	Service Renewed from house to curb			2/5/58	Labor 22 98
	39' - 1" Copper				1 1" Lead Lined Coupling 1 00
					1 1" x 5" Cement Lined Nipple 75
					1 1" Style 38 Repair Clamp 2 14
					1 Hour Town Shovel @ 6.50 6 50
					1 Hour Trucking @ 75 75
					34 12
					3/4" Copper
					3/4" x 1" Curb Stop
					Open Left

**WATER DIVISION**

Sketch of Service Here

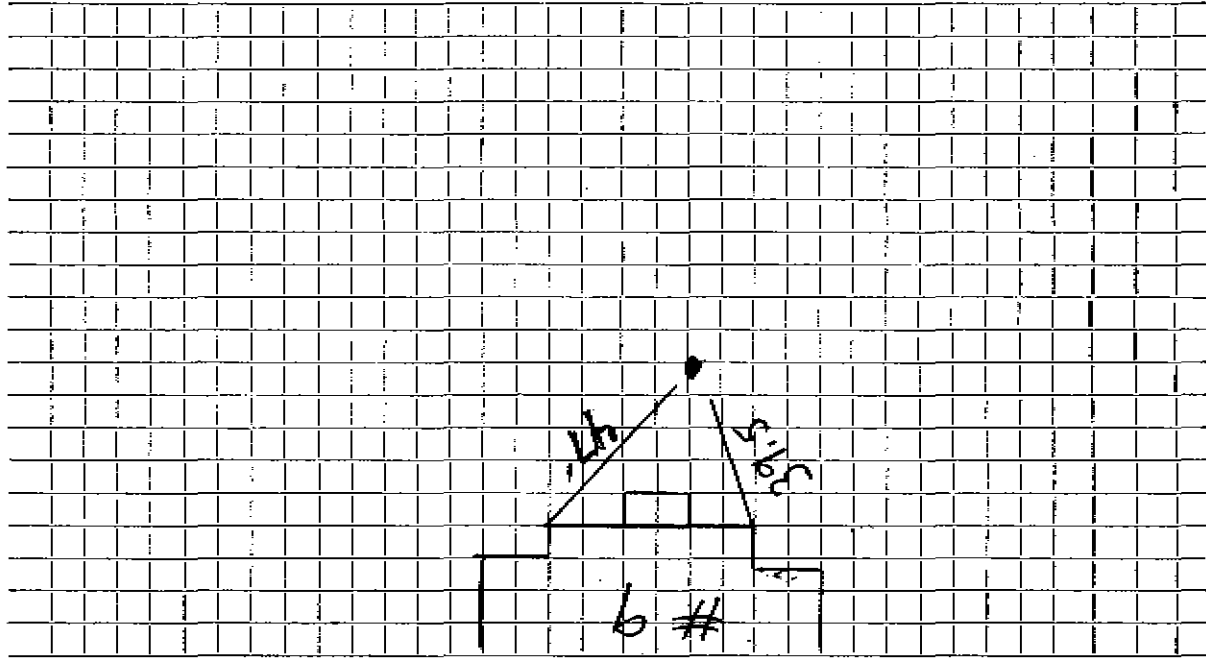

Connection made in

Street *Demanded Service*

Work completed *Same HES*

Remarks: