

WATER SERVICE RECORD

Name Wynwood Assoc.

Service No. N.D. 285

Address 1 Fulton Road

Location

~~Repair - Repair - New Service~~

Comp 11-24-58

Date	Material	Amount	Total	Date		Amount
9-30-58	Labor	2.10		10-15-58	Paid	8.90
	10 % O.H.	.21	2.31			
1	3/4" C x 1/2 I.W.H. Stop & Waste		5.84			
1	hr. Trucking @.75		.75		NON CHARGE	
			8.90	9-30-58	Labor	3.46
					14' 3/4" Copper tubing @.37	5.18
					1 3/4" C Corp Cock	4.64
					1 3/4" C Curb Cock	6.03
					1 Box & Rod	5.00
					1 1/2 Straight tailpiece	.50
					1 1/2 Offset tailpiece	.50
						25.31


*By order of Wynwood Assoc. Paid*

DATE \_\_\_\_\_

TOWN OF LEXINGTON — BOARD OF PUBLIC WORKS

WATER DIVISION

Sketch of Service Here

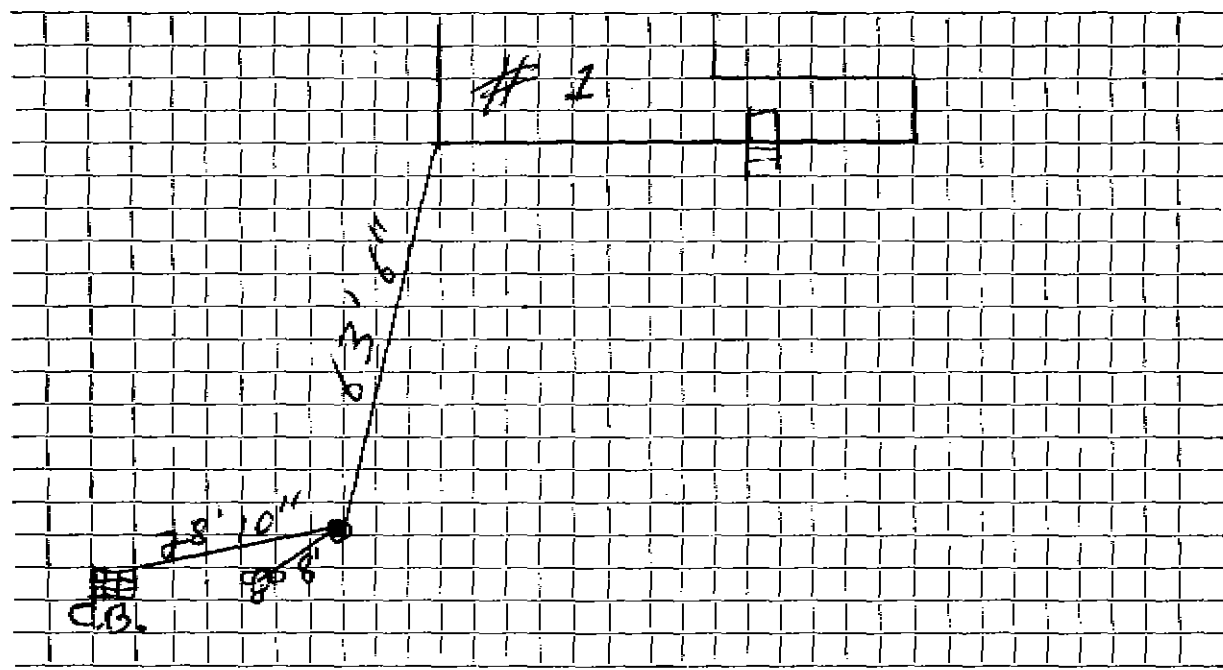

Connection made in ..... Street. Work completed .....

Remarks: .....  
.....  
.....