




DATE 7/26/18

TOWN OF LEXINGTON — BOARD OF PUBLIC WORKS  
WATER DIVISION

Sketch of Service Here

BC = 35.5'  
AC = 42.5'

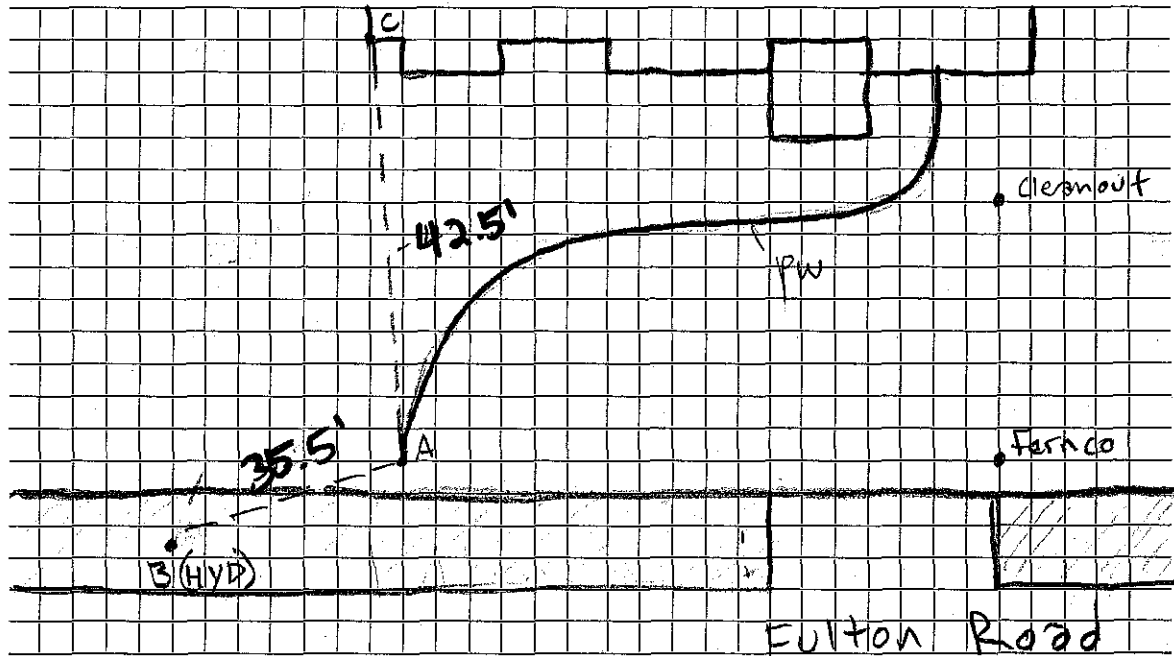

Connection made in.....Fulton.....Street. Work completed.....  
Remarks: 5' Depth.....A = 1" Curb Stop.....B = Hydrant Spindle.....