




DATE 11/6/18

TOWN OF LEXINGTON — BOARD OF PUBLIC WORKS  
WATER DIVISION

Sketch of Service Here

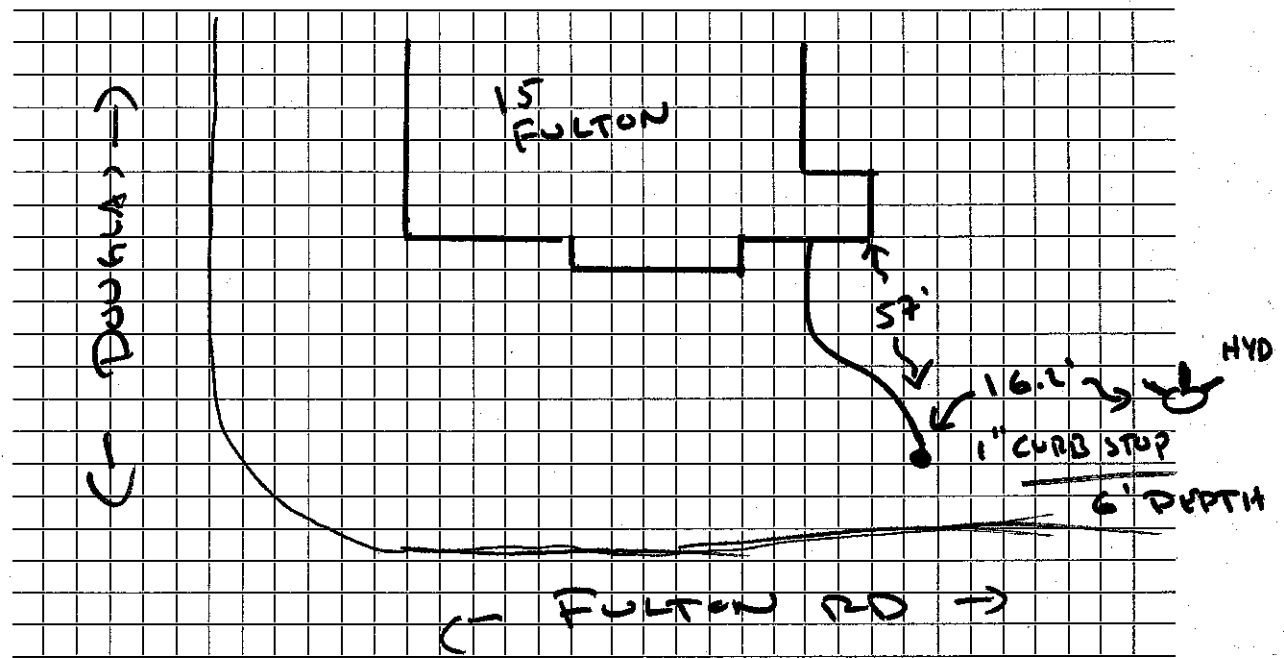

Connection made in FULTON Street. Work completed SPEED WAGON PARTNERS

Remarks: .....

.....

.....