


Date: 05/29/24

TOWN OF LEXINGTON - BOARD OF PUBLIC WORKS  
WATER DIVISION

SKETCH OF SERVICE HERE  
2 FULTON RD

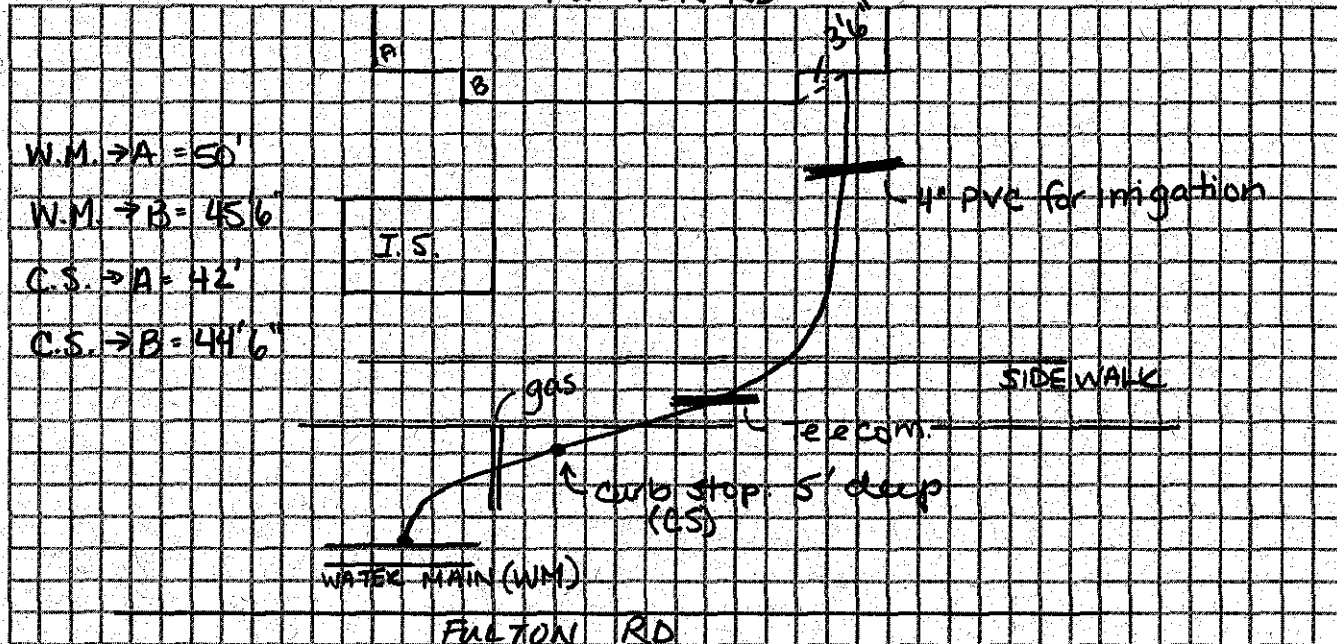

Connection made in:

Street:

Work completed:

Remarks: Installed by TBR Excavating

