

WATER SERVICE RECORD

Name Wynwood Associates

Service No. 49

Address 3 Fulton Road

4096

Location Lot #48

~~Repair - Renewal - New Service~~

Comm 6-1-59


Date	Material	Amount	Total	Date		Amount
4-21-59	Labor	29.28		4-14-59	Deposit	100.00
	10% O.H.	2.93	32.21	6-1-59	Retard	3.57
65'	3/4" Copper tubing @.3666		23.83			64.93
1	3/4" C x 1/2 I.W.H. Stop & Waste		5.87		NON CHARGE	
1	3/4" C 3 part union		2.27	9-30-58	Labor	5.44
1	hr. Trucking @.75		.75	22	3/4" Copper tubing @.37	8.14
			64.93	1	3/4" C Corp Cock	4.64
				1	3/4" C Curb Cock	6.03
				1	Box & Rod	5.00
						29.25
				1	1/2 Straight tailpiece	.50
				1	1/2 Offset tailpiece	.50
						30.25

DATE _____

TOWN OF LEXINGTON — BOARD OF PUBLIC WORKS

WATER DIVISION

Sketch of Service Here

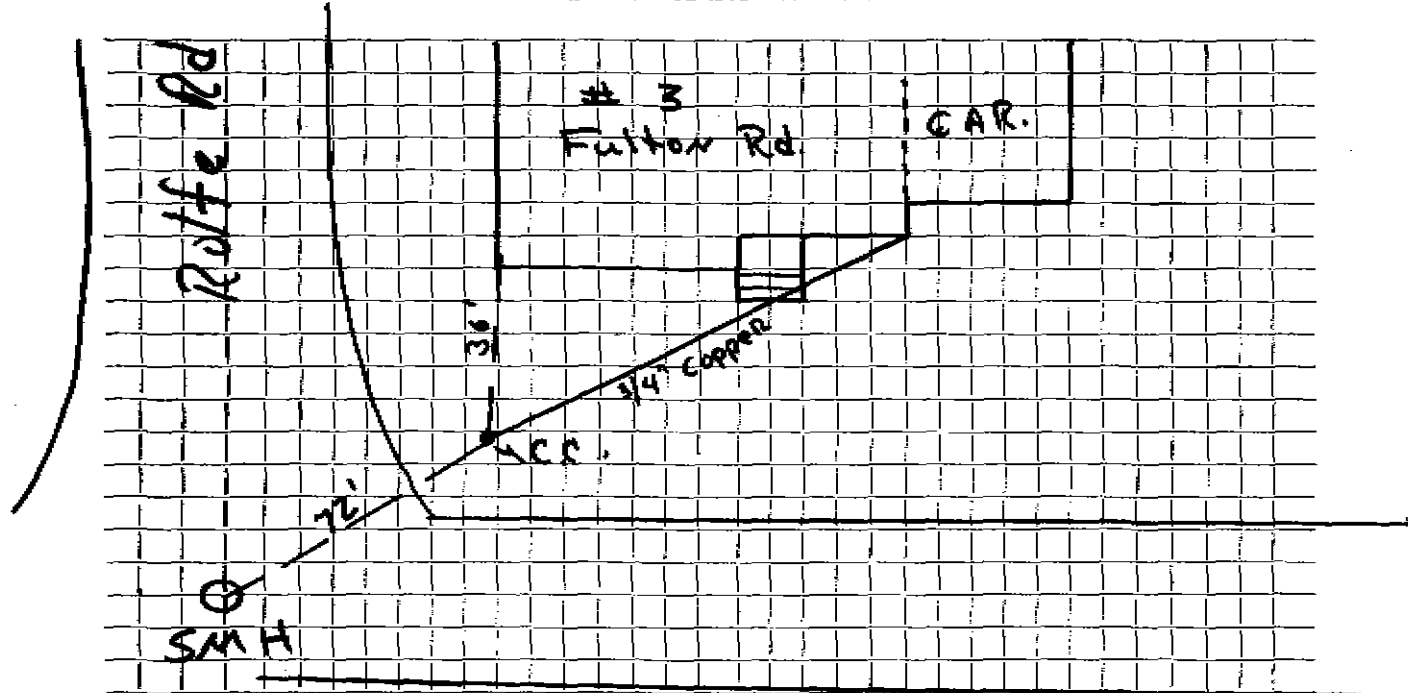

Connection made in Street. Work completed

Remarks:

.....

.....