

## WATER SERVICE RECORD

Name Wynwood Association

Service No. 237

Address 4 Fulton Rd.

Location

Repair—Renewal—New Service


Comm 12-15-58

Date	Material	Amount	Total	Date	Amount
11/6/58	Labor	6 58		11-5-58	50 00
	10% Overhead	66	7 24	12-15-58	2 45
	85' 3/4" Copper Tubing @.37	31 45			47 55
	1 3/4" C x 1/2 IWH Stop & Waste	5 84			NON CHARGE
	1 3/4" C 3 part Union		2 27	10/4/58	
	1 hr. Trucking @.75		75	Labor	7 24
			47 55	31' 3/4" Copper Tubing @.37	11 47
				1 3/4" C Corp Cock	4 64
				1 3/4" C Curb Cock	6 03
				1 Box & Rod	5 00
				1 1/2 Straight Tailpiece	50
				1 1/2 Offset Tailpiece	50
					35 38

DATE \_\_\_\_\_

**TOWN OF LEXINGTON — BOARD OF PUBLIC WORKS**  
**WATER DIVISION**

Sketch of Service Here

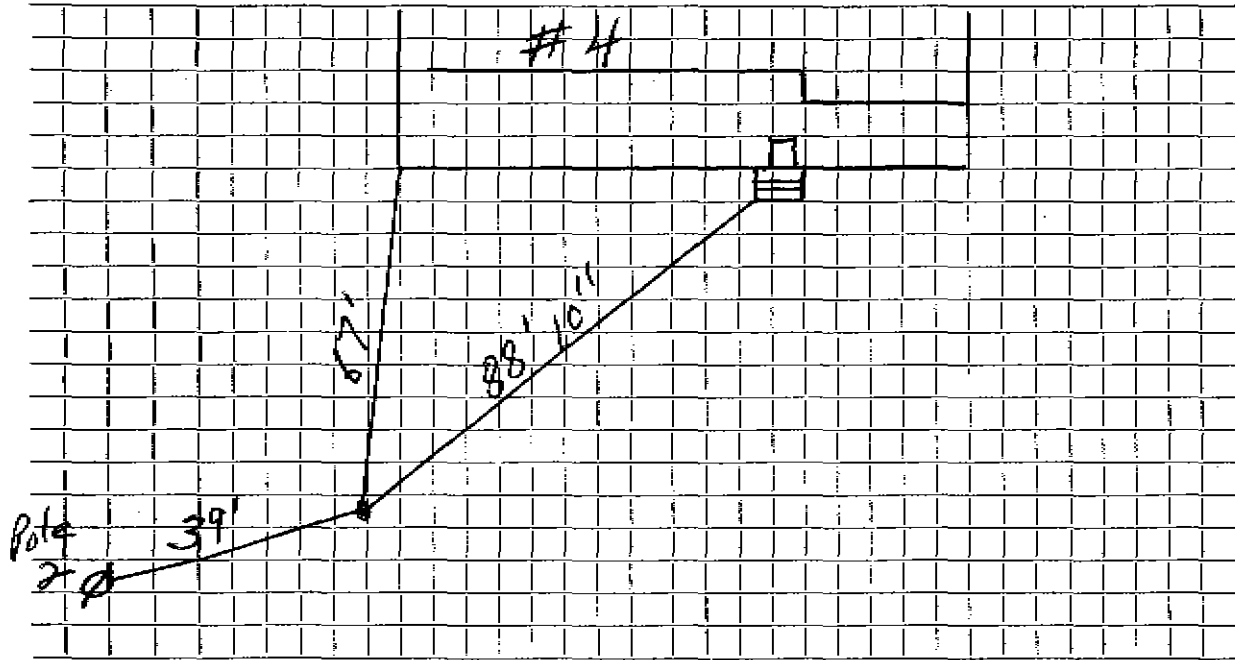

Connection made in ..... Street. Work completed .....

Remarks: .....  
.....  
.....