


Date: Oct 2021

TOWN OF LEXINGTON - BOARD OF PUBLIC WORKS
WATER DIVISON

SKETCH OF SERVICE HERE
8 Fulton Rd

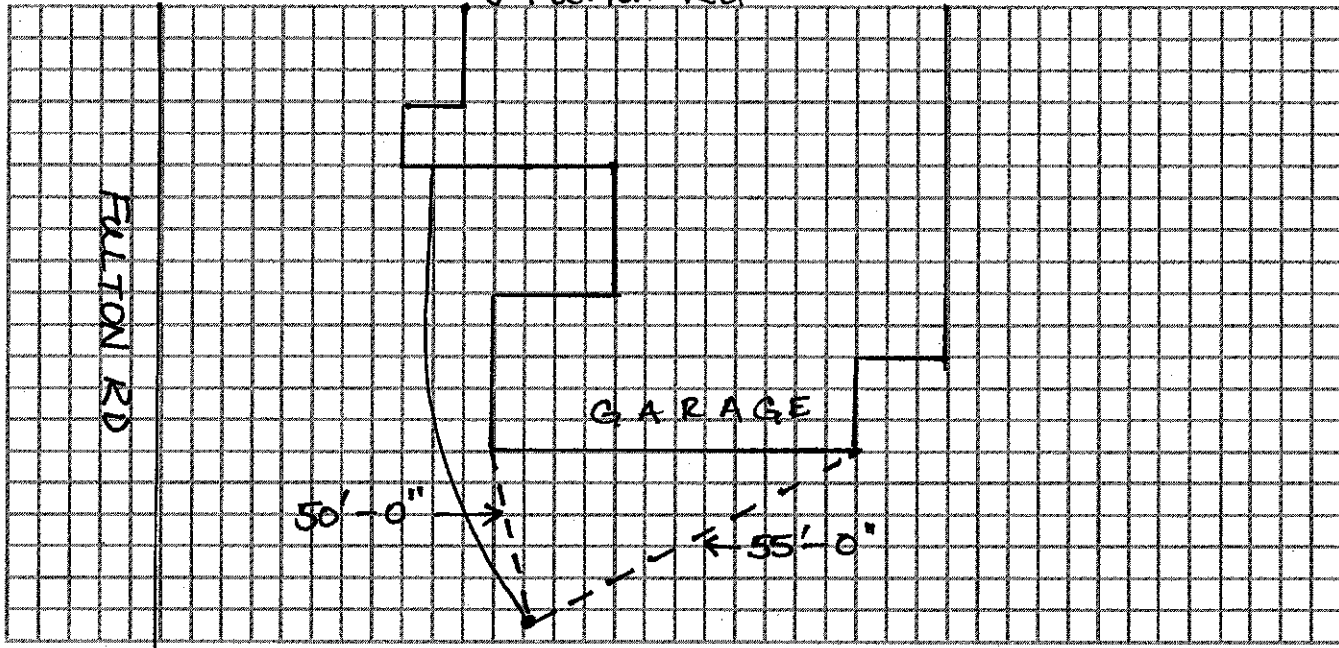

Connection made in:

Street.

Work completed:

Remarks: Installed by TBR Excavating