

## WATER SERVICE RECORD

# 4514

Name Wynwood Associates

Service No. 36

Address 9 Fulton Road

Location Lot #45 Sta. 9+18

~~REPAIR/RENEW~~ - New Service


Comm. 8-8-61

Date	Material	Amount	Total	Date		Amount
4-21-61	Labor	4.00		4-14-61	Deposit	100.00
	10% O.H.	.40	4.40	5-8-61	Refund	49.22
	70' 3/4" Copper tubing @.42		29.40			50.28
	1 3/4" C x 1/2" I.L.B. Stop & Waste		6.17		MDX CHECK	
	1 3/4" C 3 part union		2.41	8-26-60	Labor	4.36
	1 Box & Rod		4.90		12' 3/4" Copper tubing @.42	5.04
	1 hr. Trucking @3.00		3.00		1 3/4" C Corp Cock	4.92
			50.28		1 3/4" C Carb Cock	6.28
4/25/61	10' 3/4" COPPER				1 Box & Rod	4.90
	2 3/4" 3PART UNIONS					25.49
					1 1/2" Straight tailpiece	.50
					1 1/2" Offset tailpiece	.50
						26.49

DATE \_\_\_\_\_

TOWN OF LEXINGTON — BOARD OF PUBLIC WORKS  
WATER DIVISION

Sketch of Service Here

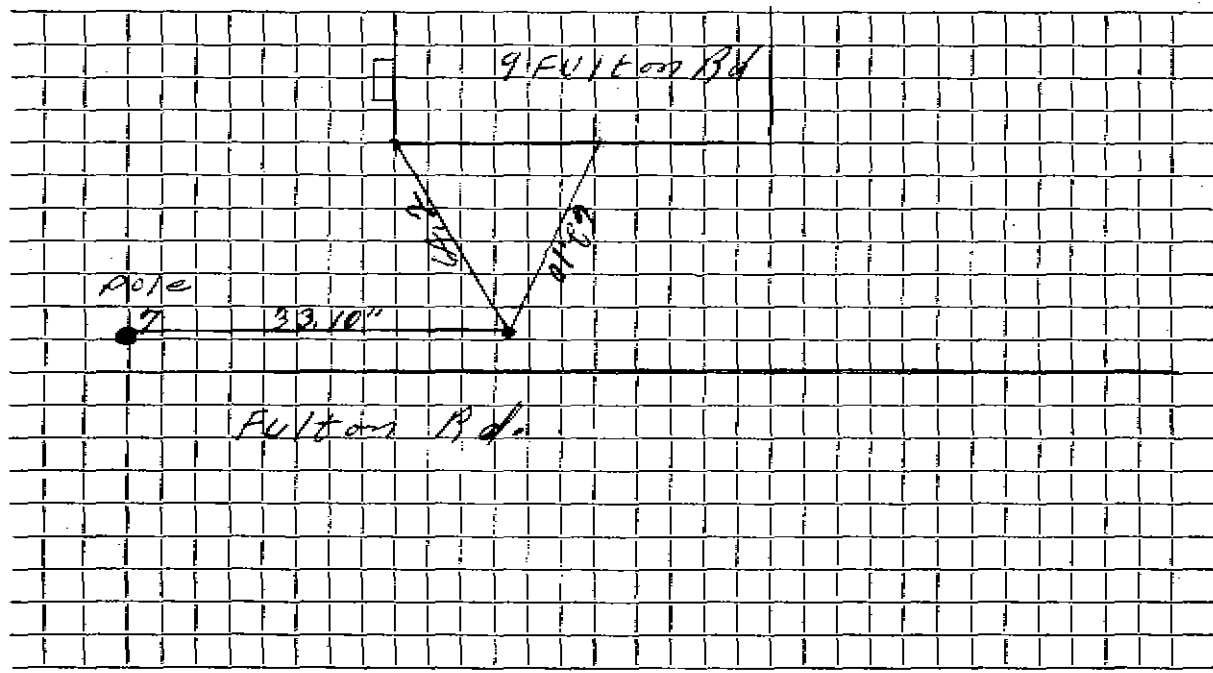

Connection made in ..... Street. Work completed .....

Remarks: .....  
.....  
.....