

WATER SERVICE RECORD

Name Conrad A. Philipson

Service No. 4

Address 4 Garden Avenue

Location

~~Repair~~ ~~Renewal~~ - New Service W.O. #7417 Great Northern

OCT 6 1980


Date	Material	Amount	Total	Date	Amount
10-1-68	Labor	23.31		<i>9-12-80</i>	<i>Deposit</i>
	10% O.H.	2.33	25.64		<i>83.04</i>
29'	3/4" Copper tubing @.79		22.91		
	Corp Cork		9.57		
1	3/4 Cur'b Cork		11.32		
1	Box & Rod		5.10		
1	hr. Town Shovel @ 6.50		6.50		
	1/2 hr. Loader @ 4.00		2.00		
			83.04		
9-17-80	74' 3/4" Copper tubing				

DATE \_\_\_\_\_

TOWN OF LEXINGTON — BOARD OF PUBLIC WORKS

**WATER DIVISION**

Sketch of Service Here

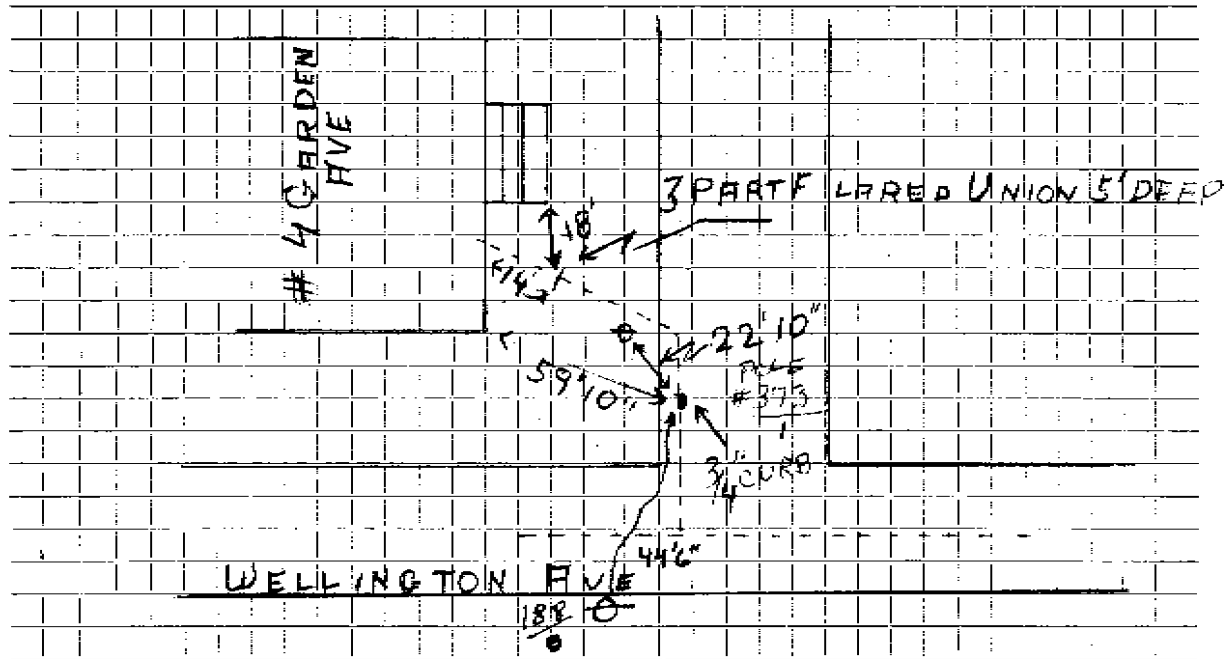

Connection made in ..... Street. Work completed .....

Remarks: ... WATER AND SEWER IN SAME TRENCH .....