

Name Anthony Waters

Service No. # 2411

Address Grandview Avenue, Lexington

Garden Service from School Street

Location Garden service from School Street

Kind of Pipe

Size

Size of Main

~~Repair - Renewal~~ New Service

Location

Date	Material	Amount	Total	Date	Amount
12/9/35	Garden Service	\$10 00		Oct 1 1935 Deposited	10 00
Com. #10.00 to Russell 12-30-35					
	Labor				

Hedley Press, Inc., Lexington

DATE October 1, 1935

# TOWN OF LEXINGTON—BOARD OF PUBLIC WORKS

## WATER DIVISION

The undersigned applies for a supply of water at No. School St St. and hereby agrees to comply with the rules and regulations as now, or at any future time, established by the Board of Selectmen.

*Garden service.*

Am't. of Estimate \$ 10.00

Owner

Anthony Waters +


Am't. Paid \$ \_\_\_\_\_

Address

\_\_\_\_\_

Builder \_\_\_\_\_

Sketch of Service Here

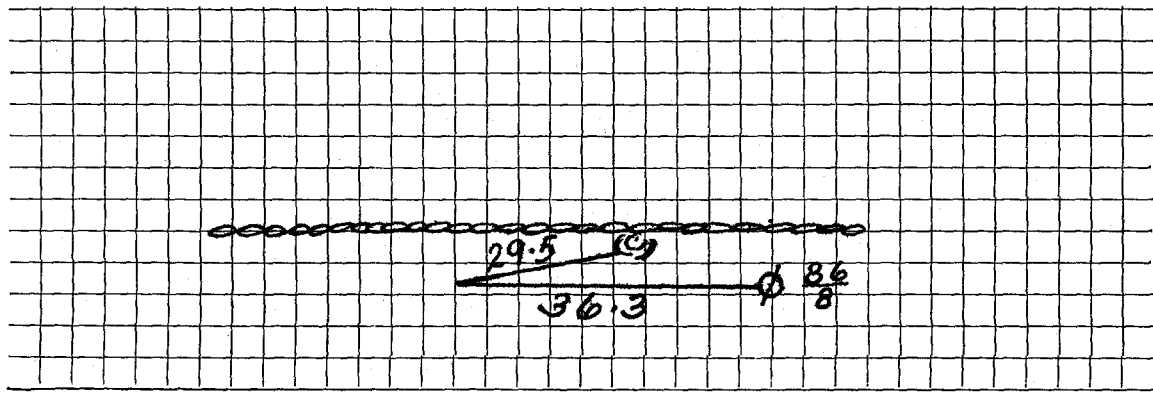

Connection made in \_\_\_\_\_ Street.

Work completed \_\_\_\_\_ 19

Remarks: