

Name James Cataldo

Service No. #1354

Address 47 Rindge Avenue

*Garden Service Haddon Street*

Location garden service - Laconia Street

Kind of Pipe

Size

Size of Main

~~Repair~~ ~~Renewal~~ — New Service

Location

Date	Material	Amount	Total	Date	Amount
1941					
July 17, <i>from 8/21/41</i>	4 hrs. @ 60¢	2 40		<i>July 14 1941 Deposited</i>	15 00
	10% Overhead	24	2 64		
	18' 1" Copper tubing @ 22¢		3 96		
	1 1" C. Corp. cock		3 75		
	1 1" C. Curb cock		3 85		
	1 1" C x 3/4" I.S. & W.		2 50		
	1 1" C Meter Stand		4 00		
	1 Box & Rod		1 60		
	1 Pit Cover		4 10		
	2' 20" Clay Pipe @ 1.50		3 00		
	1 hr. trucking @ 75¢		75		
			<u>\$30 15</u>		
	Labor CHARGE: \$15.00				

Hadley Press, Inc., Lexington

DATE \_\_\_\_\_

# TOWN OF LEXINGTON—BOARD OF PUBLIC WORKS

## WATER DIVISION

The undersigned applies for a supply of water at No. \_\_\_\_\_ St. and hereby agrees to comply with the rules and regulations as now, or at any future time, established by the Board of Selectmen.

Am't. of Estimate \$ \_\_\_\_\_


Owner \_\_\_\_\_

Am't. Paid \$ \_\_\_\_\_

Address \_\_\_\_\_

Builder \_\_\_\_\_

Sketch of Service Here

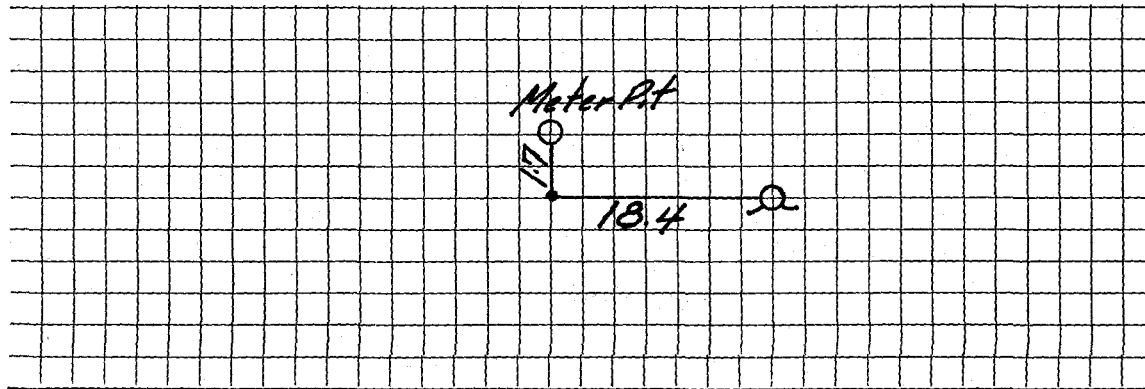

Connection made in \_\_\_\_\_ Street.

Work completed \_\_\_\_\_ 19

Remarks: