

WATER SERVICE RECORD

Name Esther M. Samson

Service No. 189

Address 11 Garfield Street

Location

~~Water - Metered~~ New Service

Comm 11-16-59

Date	Material	Amount	Total	Date	Material	Amount
8-27-59	Labor	3 80		8-19-59	Deposit	50 00
	10% O. H.	38	4 18	11-15-59	Retard	26 93
30'	3/4" Copper Tubing @.41		12 30			23 07
1	3/4" C x 1/2 I.W.H. Stop & Waste	5	8 1/2		NON CHARGE	
1	Hr. Trucking @.75		75	8-27-59	Labor	3 80
			23 07	18'	3/4" Copper Tubing @.41	7 38
				1	3/4" C Corp Cock	4 64
				1	3/4" C Curb Cock	5 94
				1	Box & Rod	5 00
				1	3/8 Straight Tailpiece	50
				1	1/2 Offset Tailpiece	50
						27 76


* Applied to 58 # 125

DATE _____

TOWN OF LEXINGTON — BOARD OF PUBLIC WORKS

WATER DIVISION

Sketch of Service Here

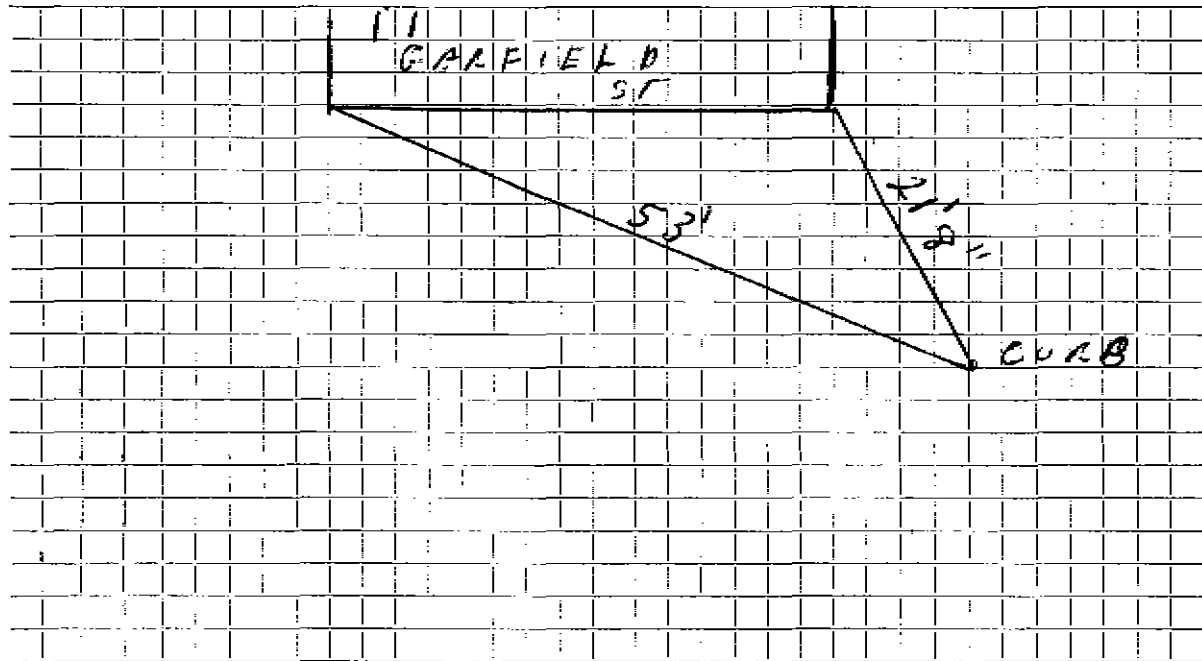

Connection made in Street. Work completed

Remarks:

.....

.....