

## WATER SERVICE RECORD

Service No. 186

Name John Donovan

Address 12 Garfield Street

Location

~~Repair Charge~~ - New Service

Comm 11-16-59


Date	Material	Amount	Total	Date	Amount	
8-19-59	Labor	3.80		9-17-59	Deposit	25.00
	10% O.H.	.38	4.18	11-16-59	Paid by SHC #136	6.08
63	3/4" Copper tubing@41		25.83	11-3-59	Paid	7.52
1	3/4" Cx 1/2 I.W.H. Stop & Waste		5.84			38.90
1	3/4" C3 Part Union		2.30		NON-CHARGE	
1	Hr. Trucking @.75		.75		Labor	3.80
			38.90		15' 3/4" Copper tubing@41	6.15
					1 3/4" C Corp Cock	4.64
					1 3/4" C Curb Cock	5.94
					1 Box and Rod	5.00
					1 1/2 Straight tailpiece	.50
					1 1/2 Offset tailpiece	.50
						26.53

DATE \_\_\_\_\_

TOWN OF LEXINGTON — BOARD OF PUBLIC WORKS

WATER DIVISION

Sketch of Service Here

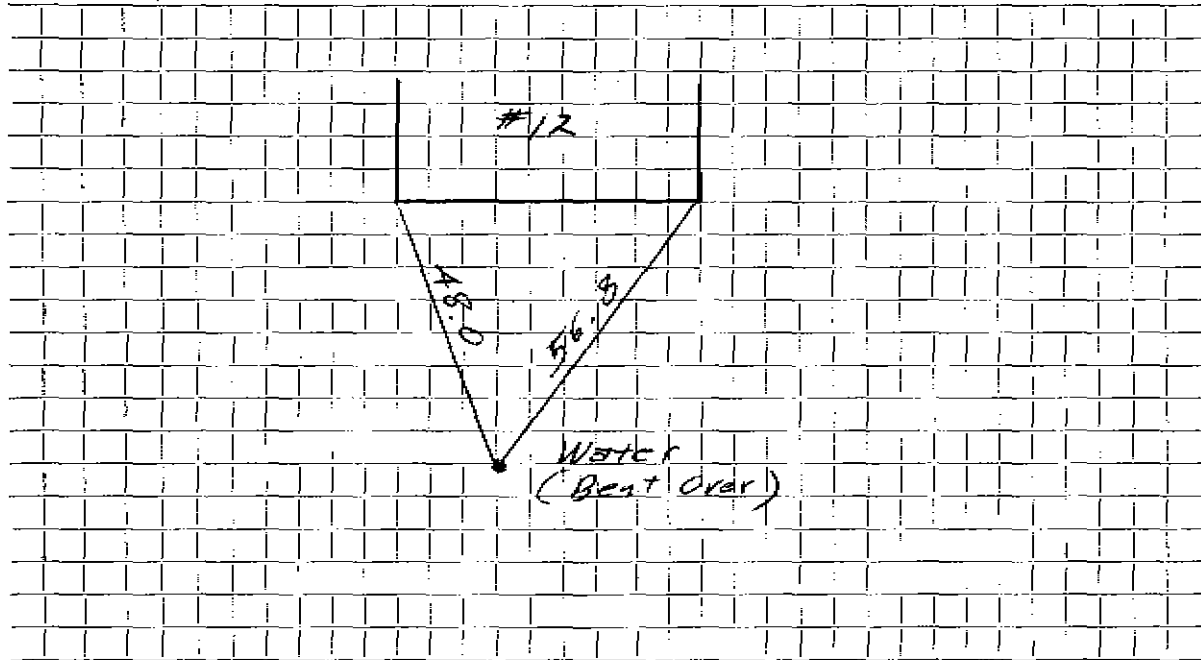

Connection made in ..... Street. Work completed .....

Remarks: .....

.....

.....