

WATER SERVICE RECORD

#368

Name Joseph Casey

Service No. 3 1522

Address 15 Garfield Street

Location

~~W.O.#7798~~ New Service

W.O.#7798


Comm 5-27-63

Date	Material	Amount	Total	Date		Amount
4-16-63	Labor	2.31		3-11-63	Deposit	50.00
	10% O.H.	.23	2.54	5-27-63	Paid by SMCH 7	4.15
44	3/4" Copper tubing @.42		45.44			54.15
1	3/4" C x 1/2" I.W.H. Stop & Waste		6.17		NON CHARGE	
			54.15	4-16-63	Labor	2.13
				25'	3/4" Copper tubing @.42	10.50
				1	3/4" C Curb Cock	6.28
				1	3/4" C Corp Cock	4.91
				1	Box & Rod	4.90
				1	1/2" Straight tailpiece	.50
				1	1/2" Offset tailpiece	.50
						29.72

TOWN OF LEXINGTON — BOARD OF PUBLIC WORKS
DATE _____

WATER DIVISION

Sketch of Service Here

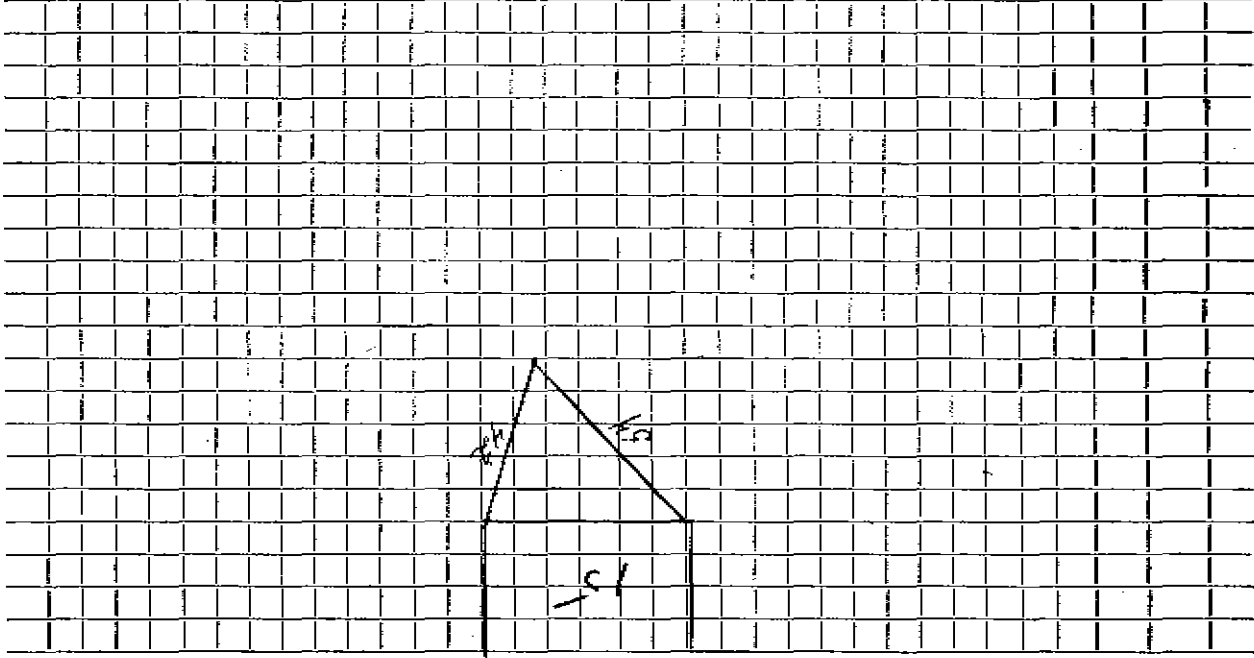

Connection made in _____

Street _____

Work completed _____

Remarks : _____

